


T.36S.R.14W.W.M.

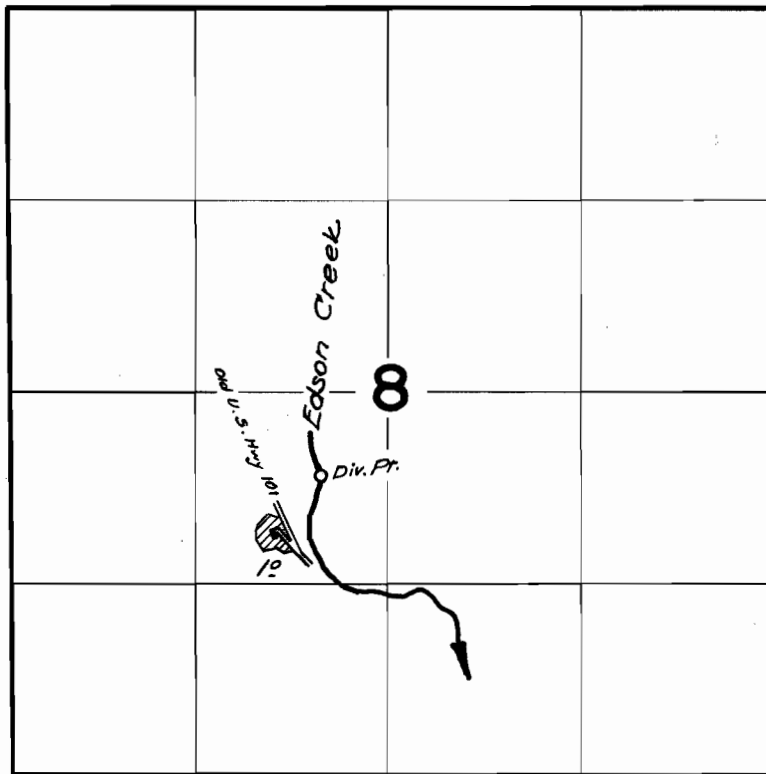

**FINAL PROOF SURVEY**  
UNDER

Application No. **31653** Permit No. **24977**  
IN NAME OF

**MRS. VIOLA B. MORSING**

Surveyed *August 1 1961* by *R. Johnson*