


T.41S.R.13W.W.M.

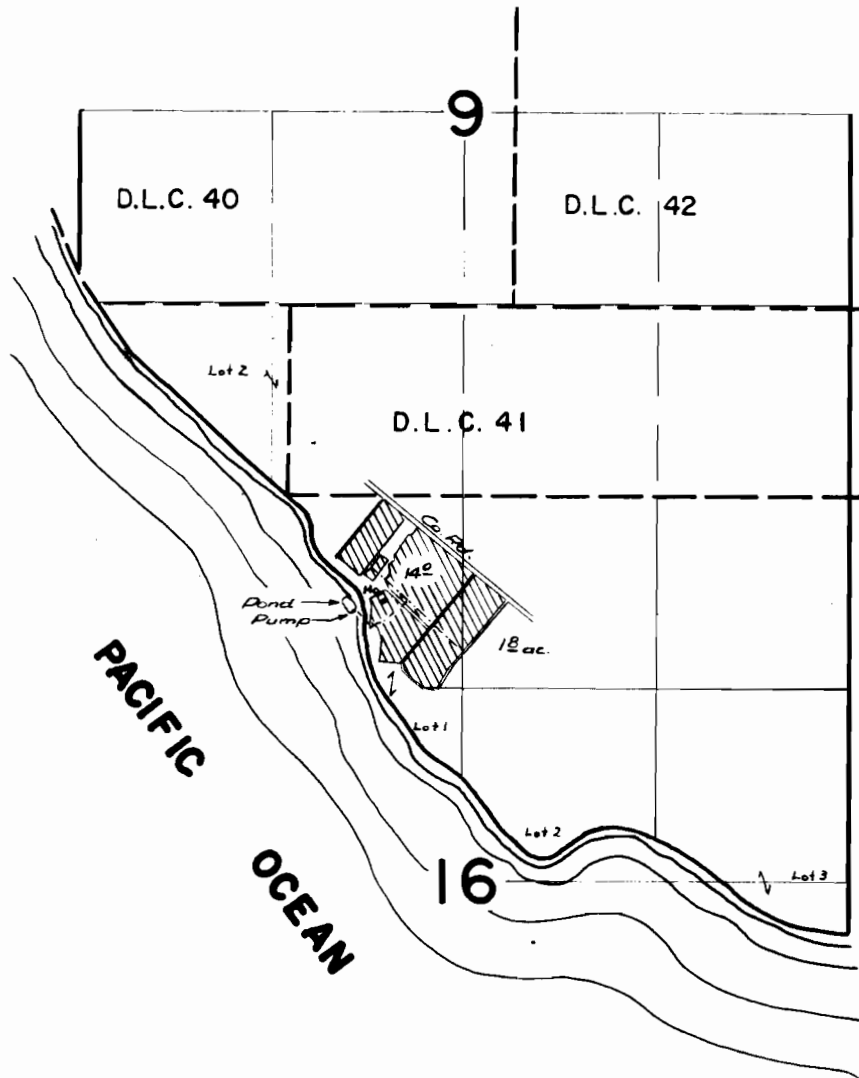

FINAL PROOF SURVEY
UNDER

Application No. 32459 R-32696 Permit No. 25674 R-2179
IN NAME OF

JOSEPH ZUMPF

Surveyed 4 AUG. 1961, by Tr. Bish