


T.41S.R.13W.W.M.

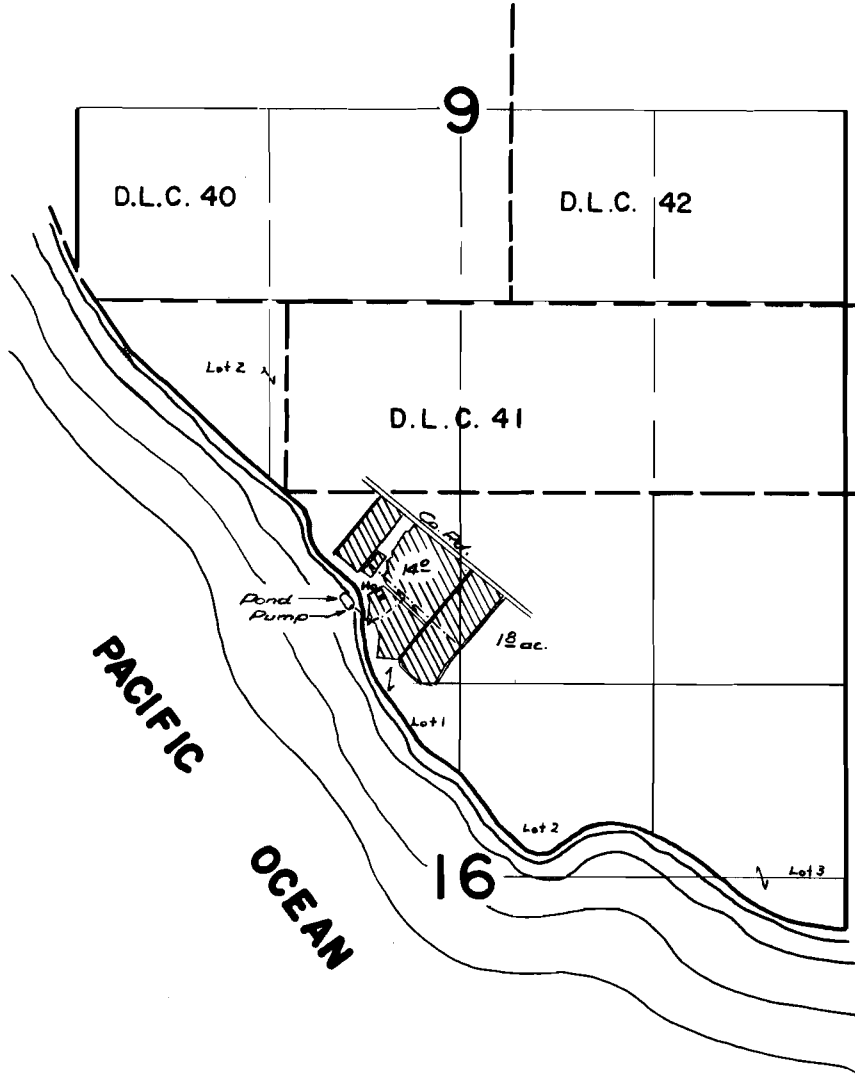

**FINAL PROOF SURVEY**  
UNDER

Application No. 32459 Permit No. 25674  
R-32696 R-2179  
IN NAME OF

JOSEPH ZUMPF

Surveyed 4 Aug. 1961, by M. Bish