


# T.35 S. R.11 W.W.M.

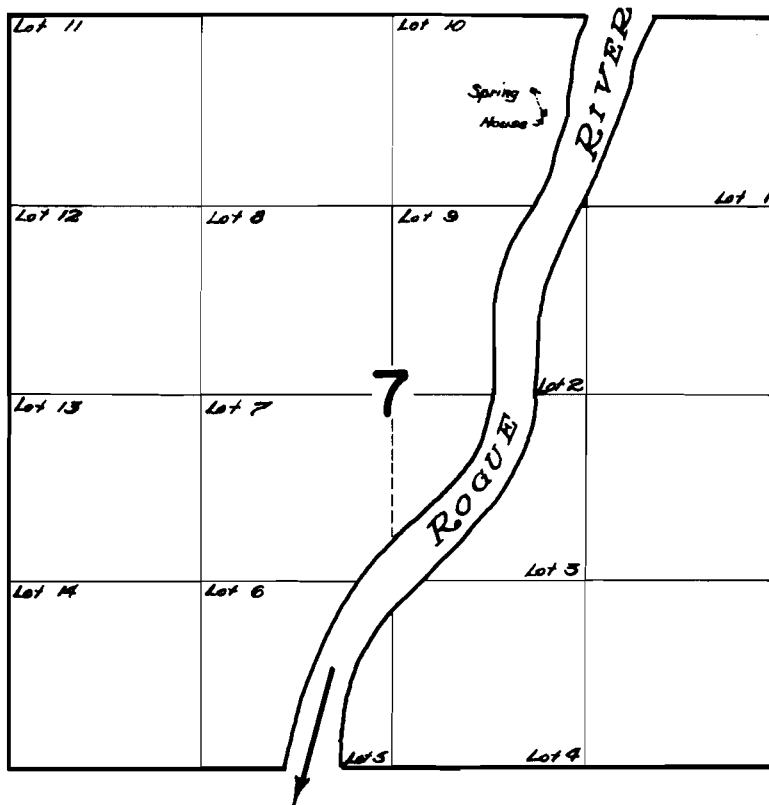

## FINAL PROOF SURVEY UNDER

Application No. **32518**..... Permit No. **25689**..  
IN NAME OF

.....**RICHARD D. HANEN**.....

Surveyed *August 29* 1961, by *C.O. Bartels*.