


T.41S.R.13W.W.M.

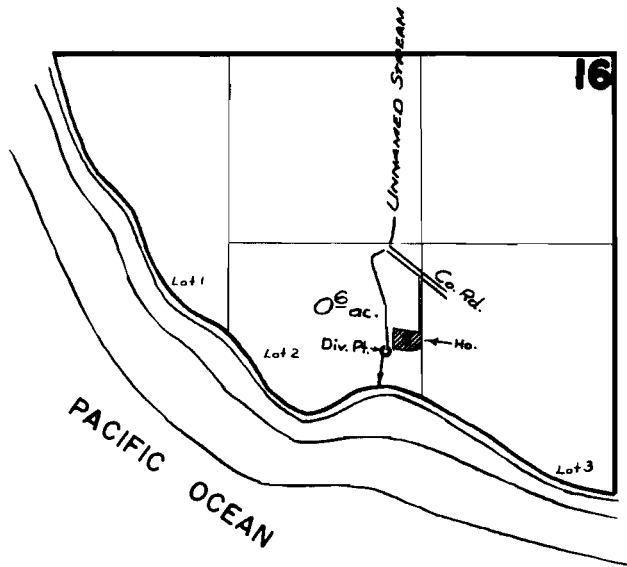

**FINAL PROOF SURVEY**  
UNDER

Application No. 32654 Permit No. 25751  
IN NAME OF

DAVID R. BROWN

Surveyed 4 AUG. 1961, by m. B. [Signature]