


# T.35 S.R.11 W.W.M.

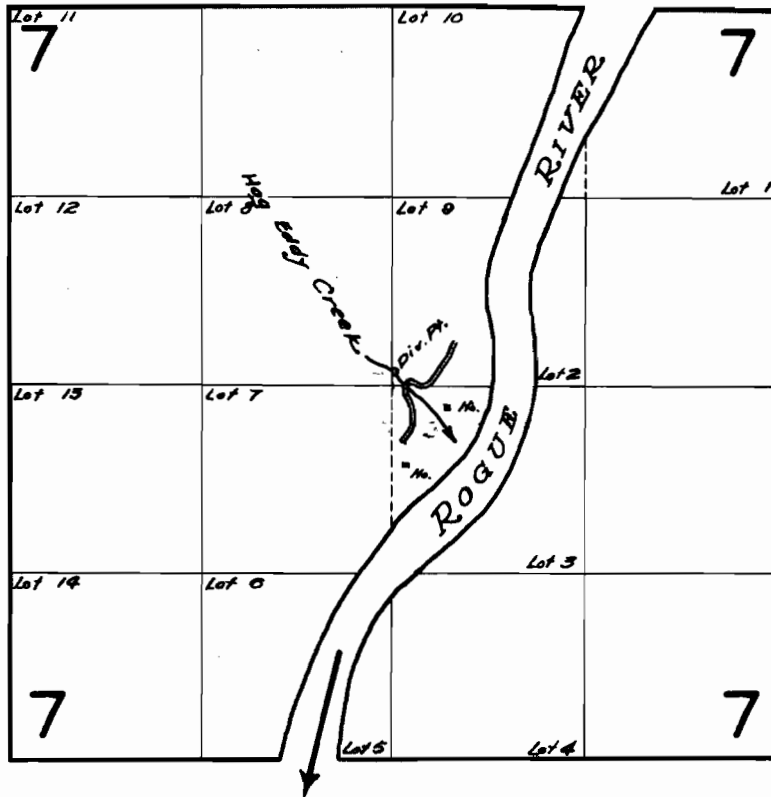

## FINAL PROOF SURVEY UNDER

Application No. **32098**..... Permit No. **25923**.....  
IN NAME OF  
**ARCHIE P. BOYD AND**  
**WESLEY MORGAN**

Surveyed *August 28 1961.*, by *C.O. Bartels.*