


T.34S.R.11W.W.M.

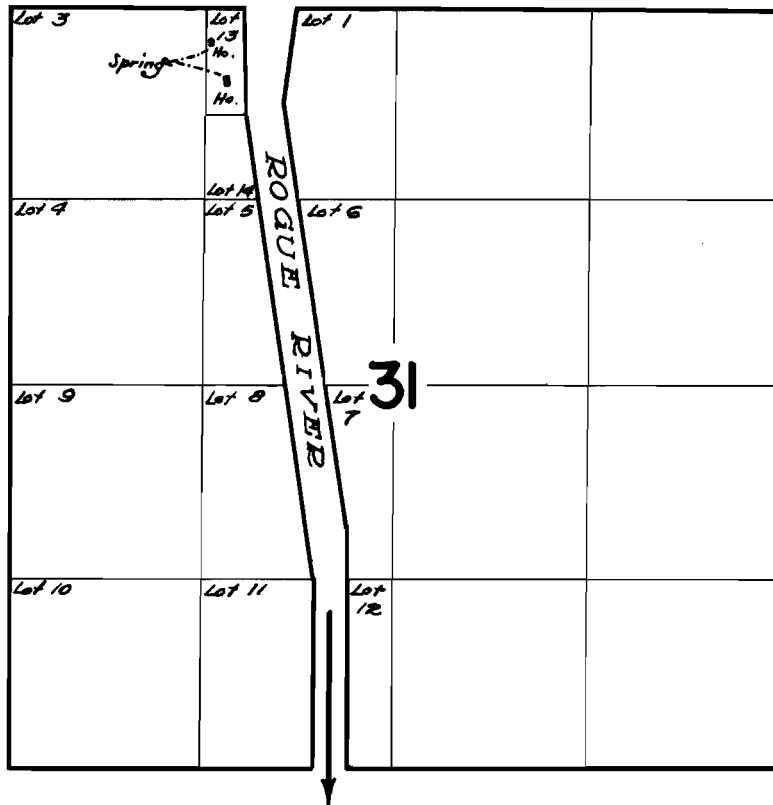

FINAL PROOF SURVEY
UNDER

Application No. **33435**... Permit No. **26492**...
IN NAME OF

WESLEY H. & BETTY J. MORGAN

Surveyed *August 29 1961*., by *C. O. Bartels*..