


T.36S.R.14W.W.M.

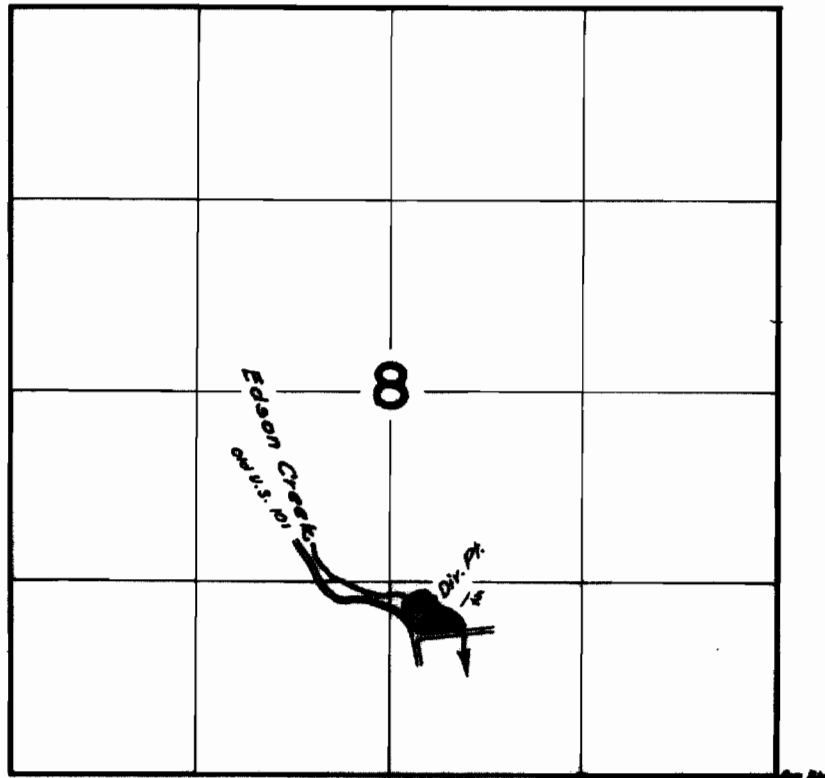

FINAL PROOF SURVEY
UNDER

Application No. 34346 Permit No. 27006
IN NAME OF

WALTER D. & VIRGINIA D. CASON

Surveyed August 1, 1961, by [Signature]