


T. 32 S. R. 4 W. W. M.

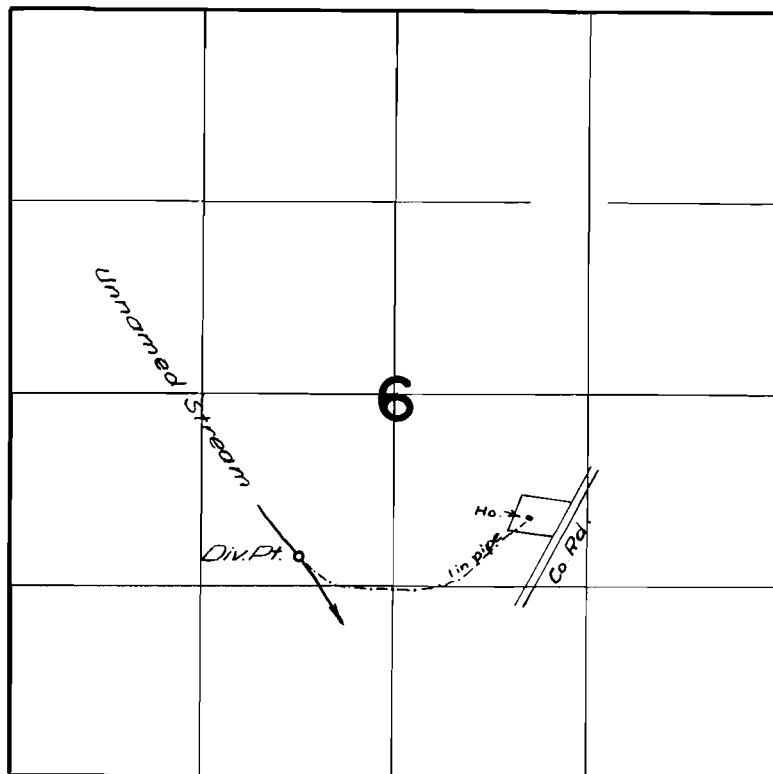

FINAL PROOF SURVEY
UNDER

Application No. 20503 Permit No. 16005
IN NAME OF

EUGENE & ELSIA PRINCE

Surveyed 27 June 1960, by Mr. Bish