


T.30S.R.2W.W.M.

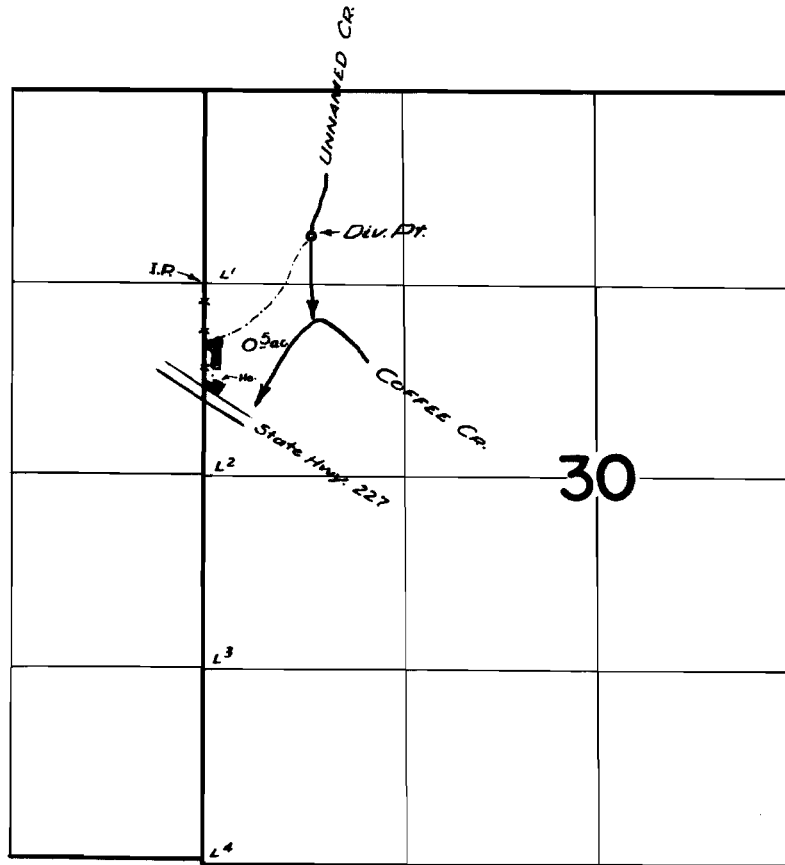

FINAL PROOF SURVEY UNDER

Application No. 27870 Permit No. 21957
IN NAME OF

ANNA B. KNUDTSON

Surveyed 13 JUNE 1961, by M. A. Bish