


# T.30S.R.5W.W.M.

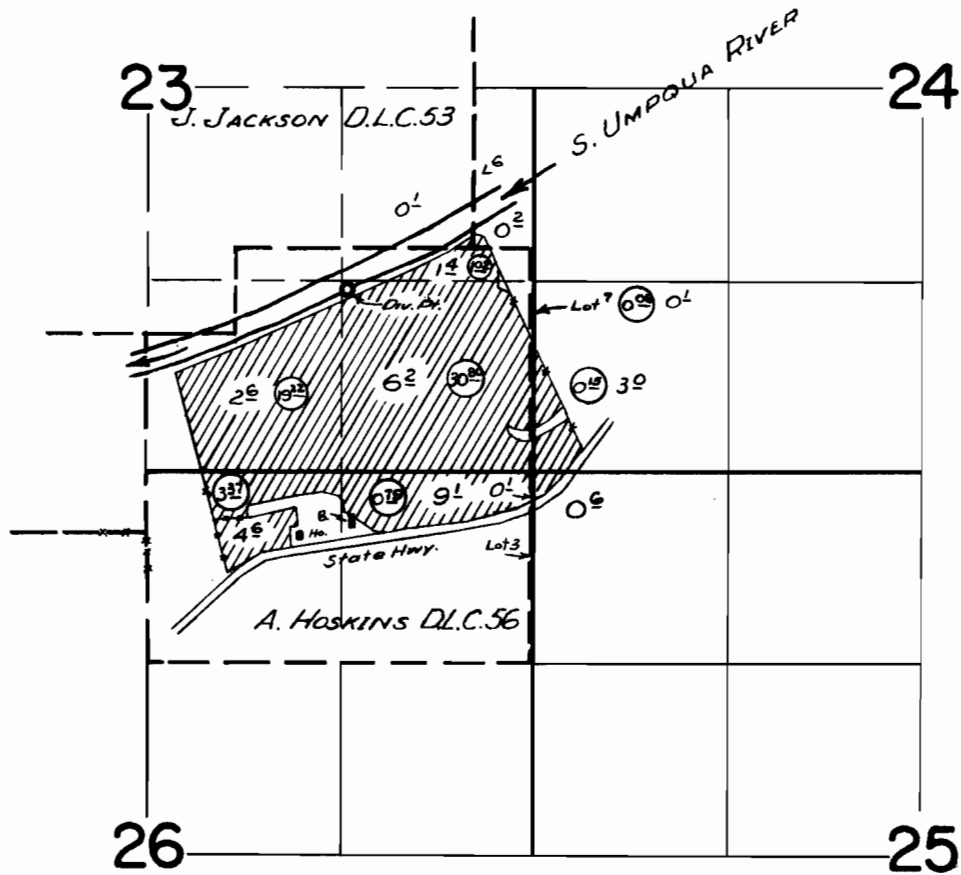

## FINAL PROOF SURVEY UNDER

CERT. 23684 ○

Application No. 30620 Permit No. 24124  
IN NAME OF

DARRELL E. & LILLIAN BROWN

Surveyed 14 JUNE 1961, by M. Bishop