


T. 28S. R. 4W. W.M.

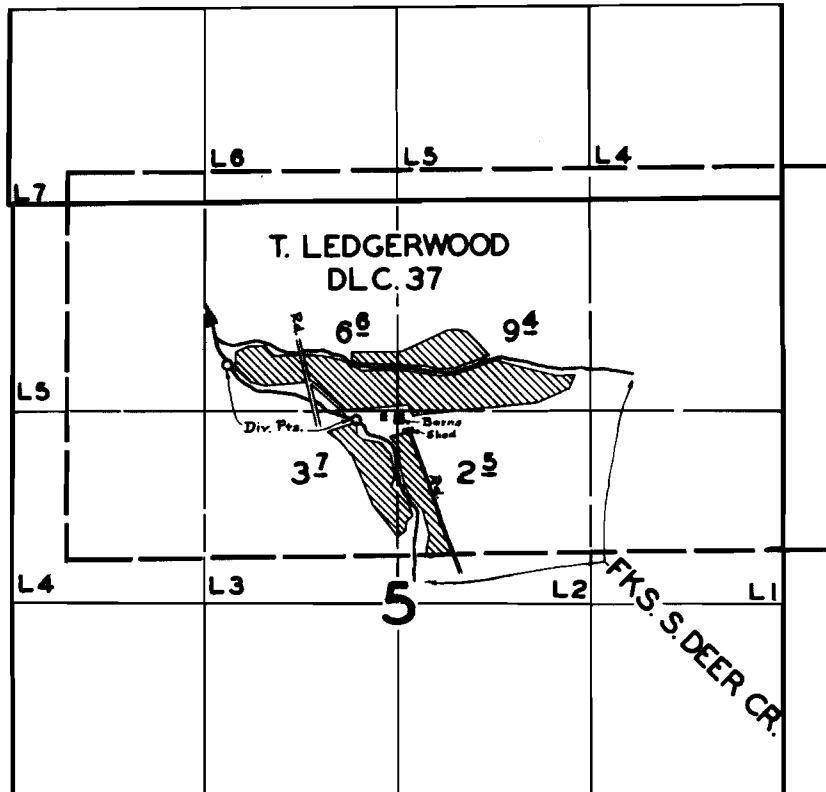

**FINAL PROOF SURVEY**  
UNDER

Application No. 30387 Permit No. 24828  
IN NAME OF

**JAMES & MRS. C. J. INGRAM**

Surveyed JUN. 26 1959, by M. BISH