


T. 29S. R. 4 W. W. M.

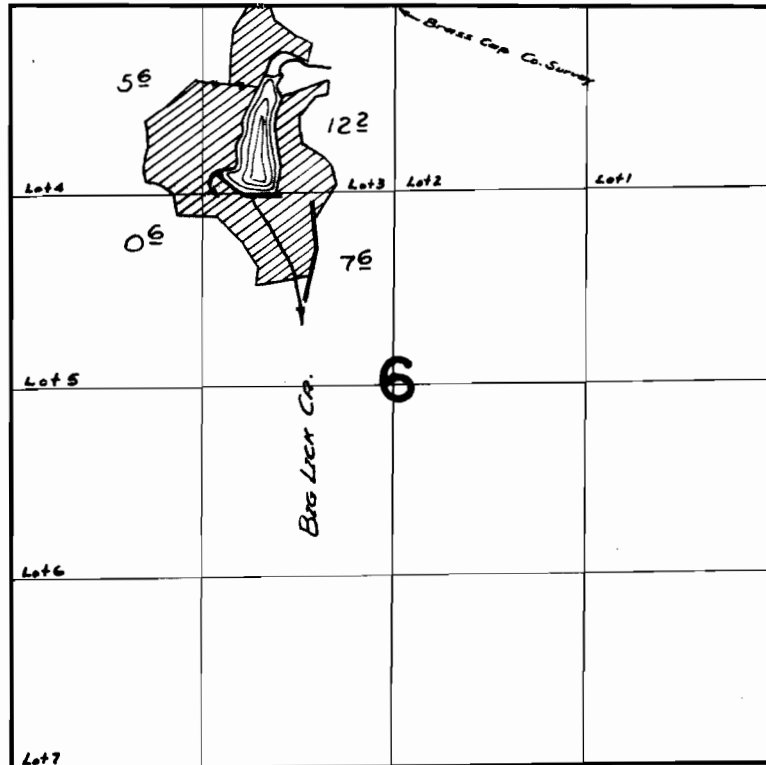

FINAL PROOF SURVEY
UNDER

Application No. 32088 Permit No. 25539
R-32087 R-2149
IN NAME OF

DURANT WADSWORTH

Surveyed 15 June 1961, by M. Bish