


T.13S.R.31E.W.M.

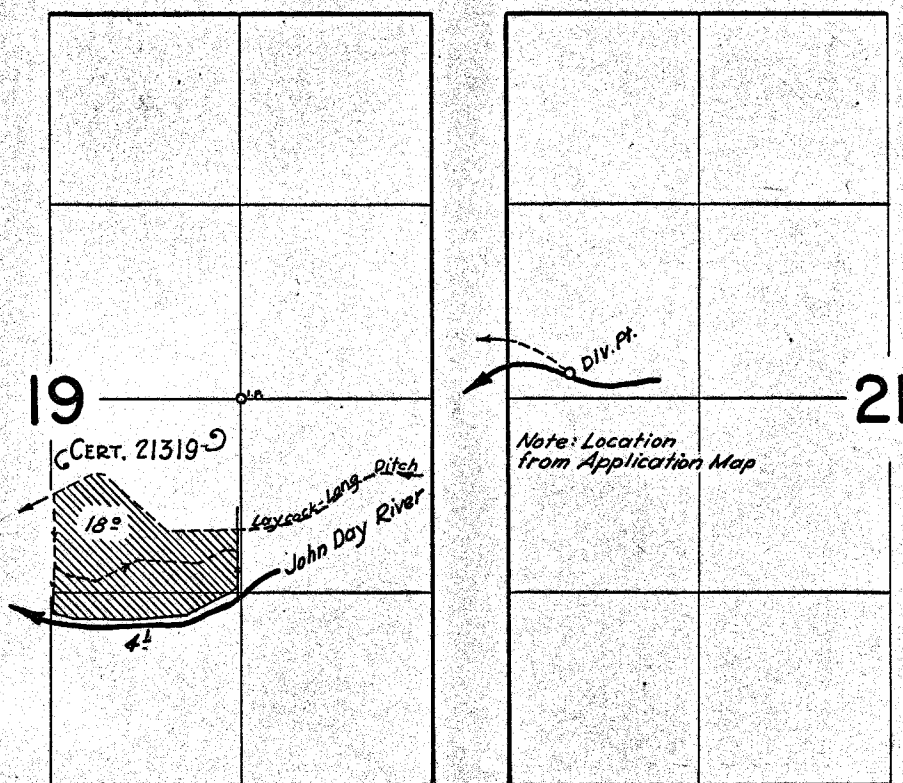

FINAL PROOF SURVEY
UNDER

Application No. 30707... Permit No. 24189...
IN NAME OF

CLARK MORRIS

Surveyed Sept. 21, 1961, by *R. Jackson*