


T.12 & 13 S. R. 26 E. W.M.

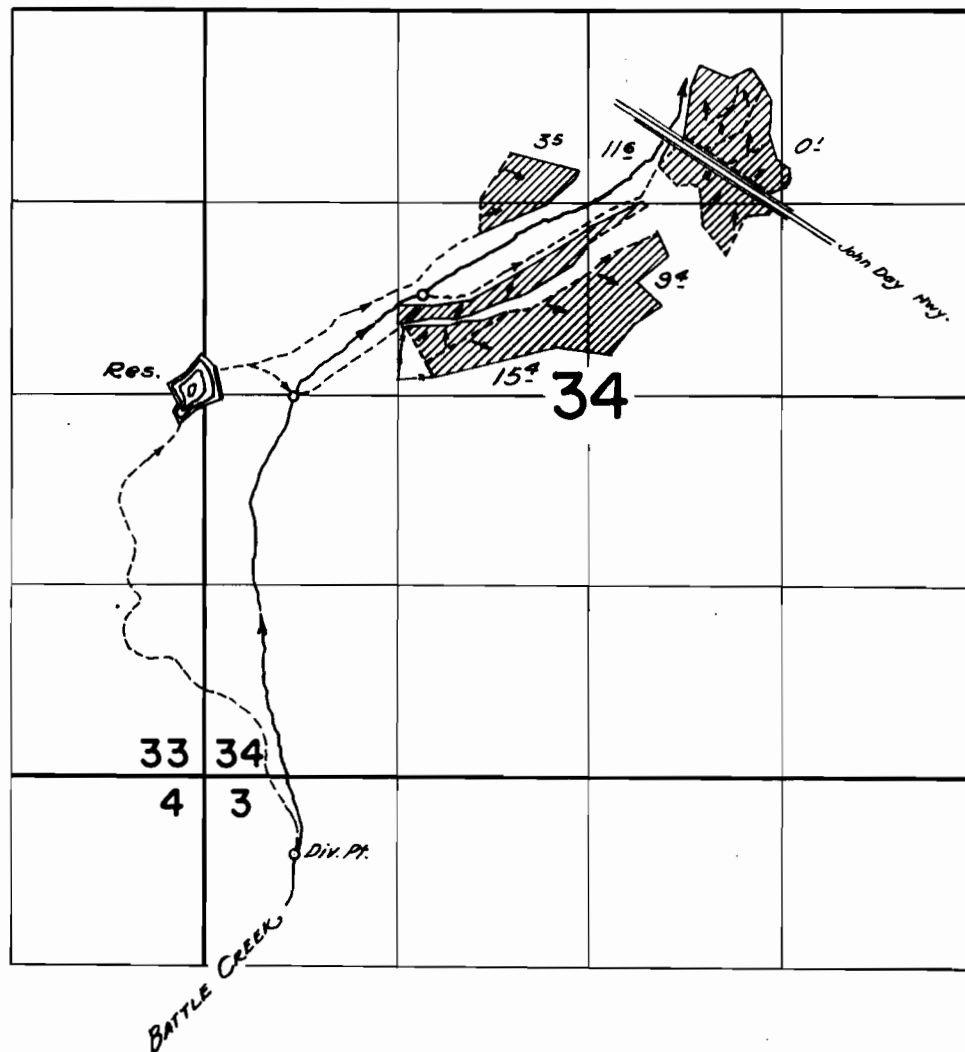

FINAL PROOF SURVEY

UNDER

R-30761 R-1992
 Application No. 30762 Permit No. 24716
 IN NAME OF

EZRA A. NASH

Surveyed July 16, 1957, by R.H. Whitby
 Aug. 25, 1961, by R. Jackson