


26200  
18785

# T.12 & 13 S. R. 26 E. W.M.

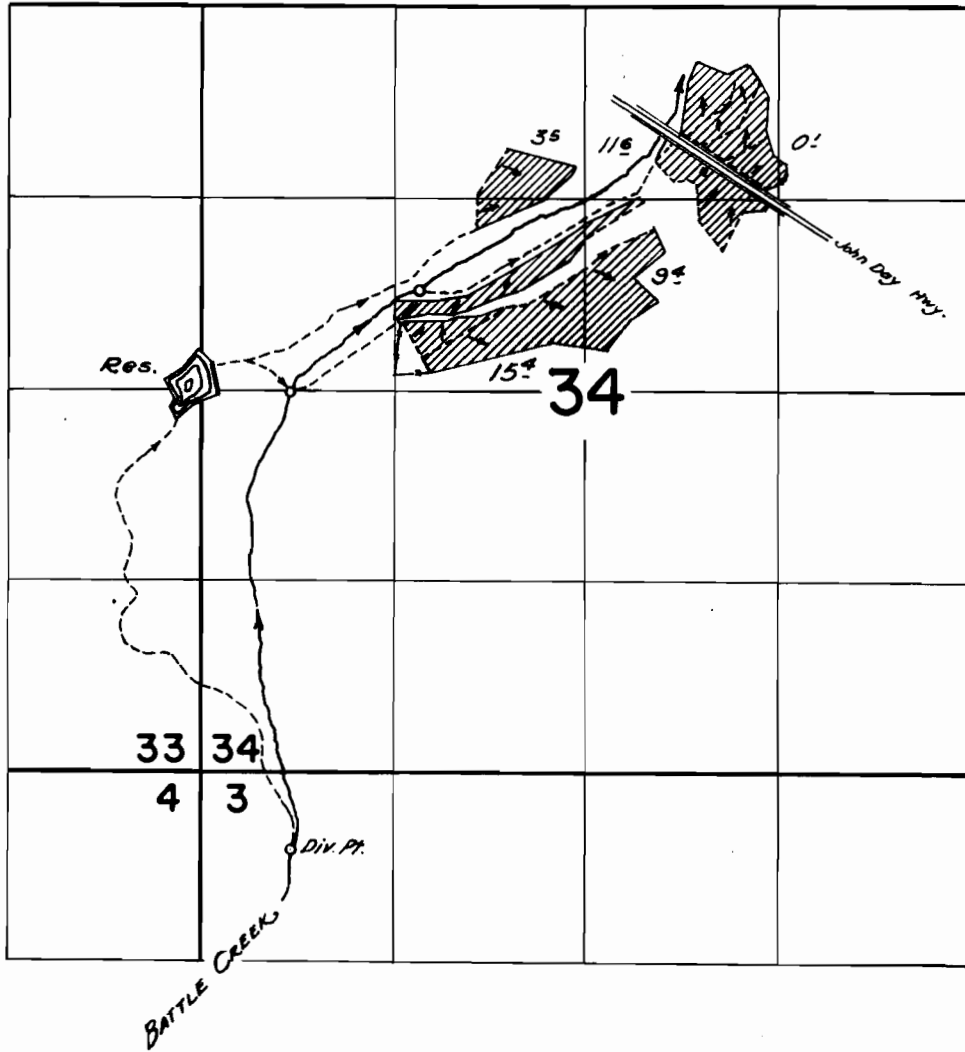

## FINAL PROOF SURVEY UNDER

R-30761                      R-1992  
Application No. 30762    Permit No. 24716  
IN NAME OF

**EZRA A. NASH**

Surveyed July 16, 1957, by R. H. Whitty.....  
              Aug. 25, 1961, by *R. Jackson*