


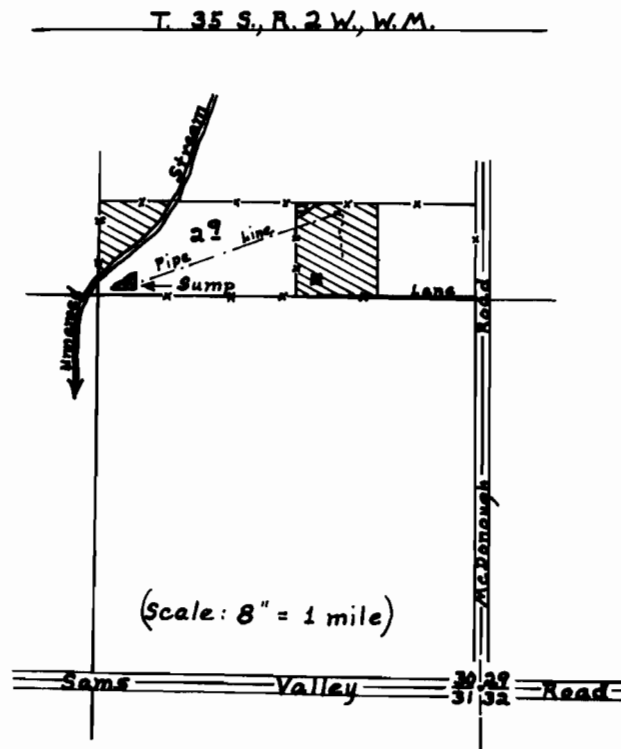

FINAL PROOF SURVEY UNDER

Application No. 6-688 Permit No. 6-596
IN NAME OF

Mrs. Loyd Dusenberry

Surveyed March 20, 1962, by D. L. Hendrix