


T. 36 S., R. 1 W., W.M.

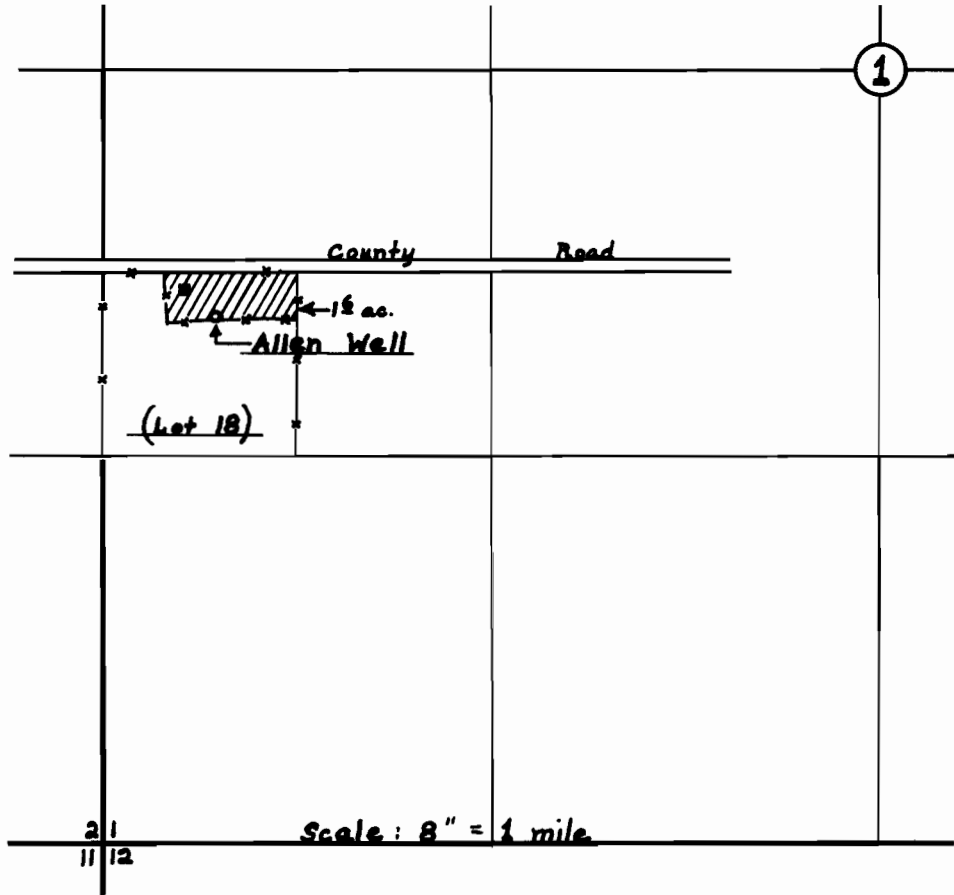

**FINAL PROOF SURVEY**  
UNDER

Application No. G-767 Permit No. G-659  
IN NAME OF

Andy E. Allen

Surveyed April 4, 1962, by D. G. Hendrix