


T.36S. R.2 W.W.M.

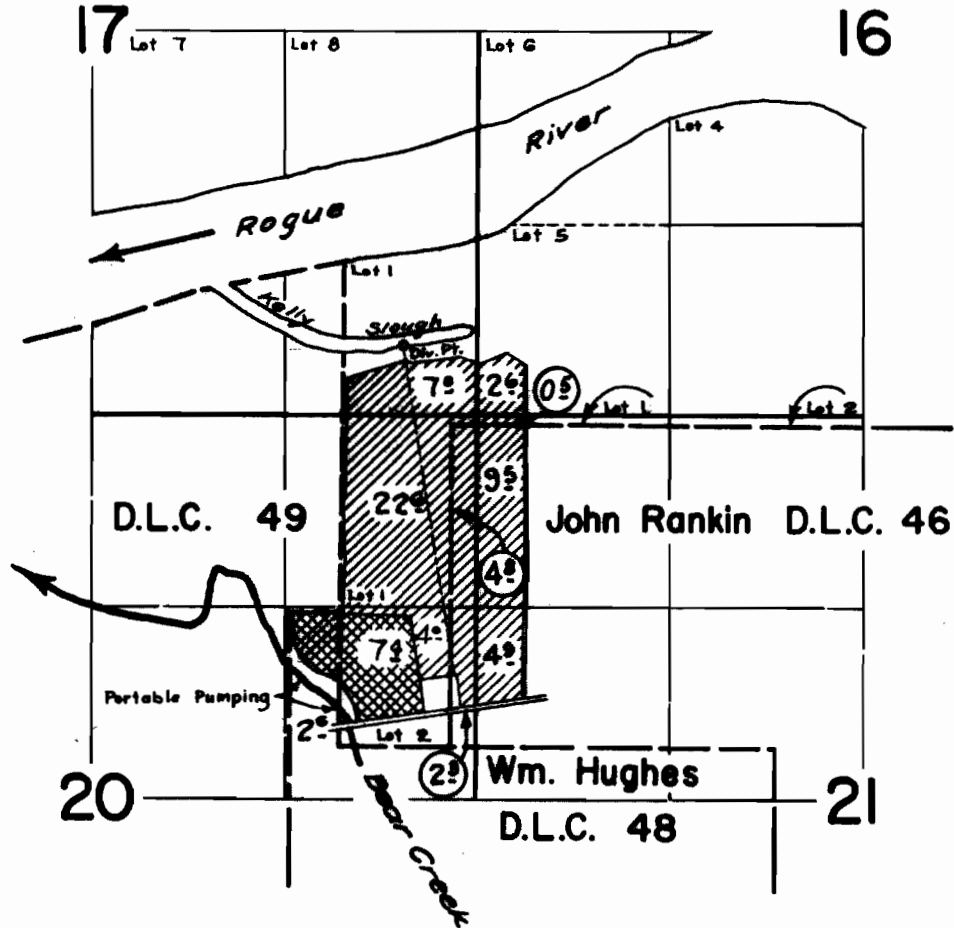

FINAL PROOF SURVEY
UNDER

Application No. 29723... Permit No. 23400...
IN NAME OF

.....WILTON A. WHITE.....

Surveyed April 18 1961, by *A. Jackson*