


T. 36 S., R. 1 W., W.M.

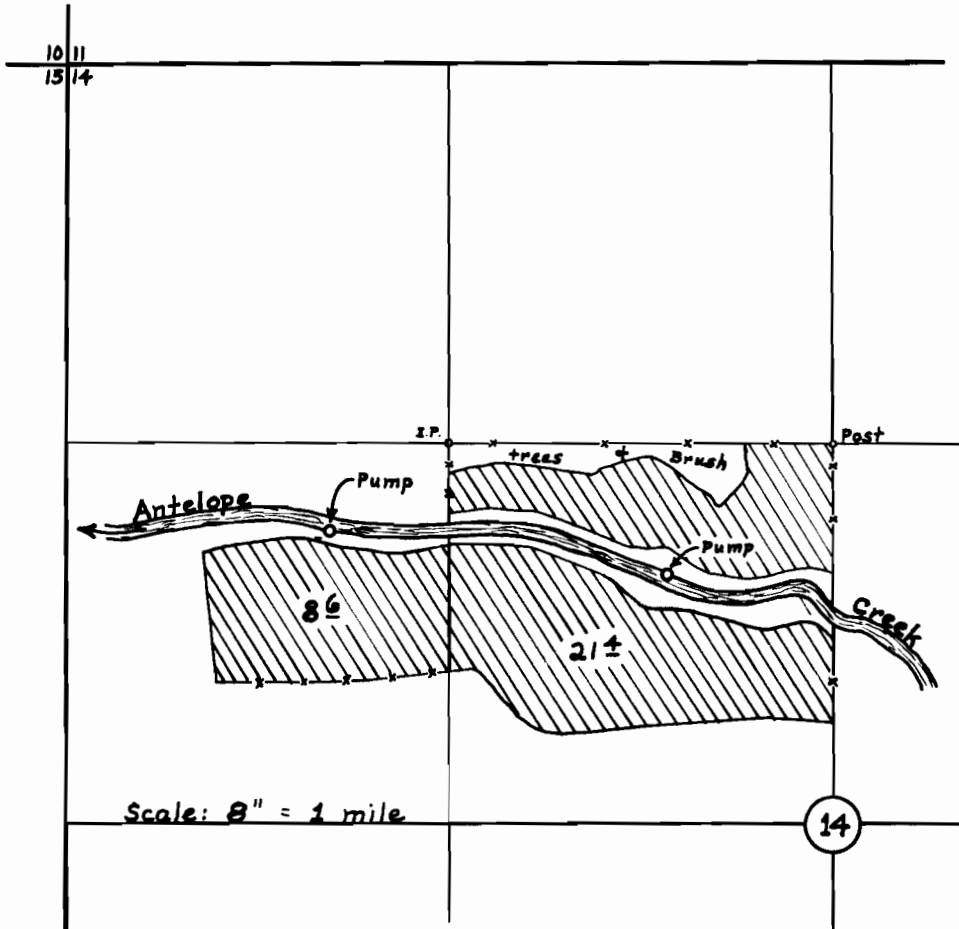

FINAL PROOF SURVEY
UNDER

Application No. 30676 ... Permit No. 24154 ...
IN NAME OF

... Adolph T. Wattenberg ...

Surveyed April 4, 1962, by P. G. Hendrix ...