


37-6-3

R-2155

T.37S.R.6W.W.M.

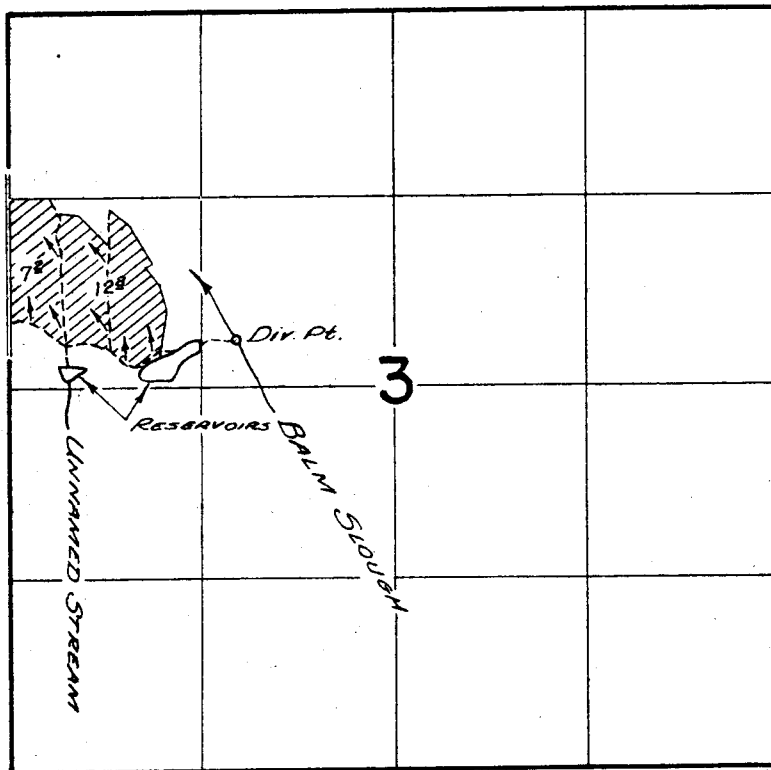

FINAL PROOF SURVEY UNDER

Application No. *R-32321* ~~32450~~ Permit No. *R-2155* ~~25627~~
IN NAME OF

.....
Surveyed *APRIL 11* 1961, by *C. Bartels*.....

Un-named Res.