


T. 37 S. R. 6 W. W. M.

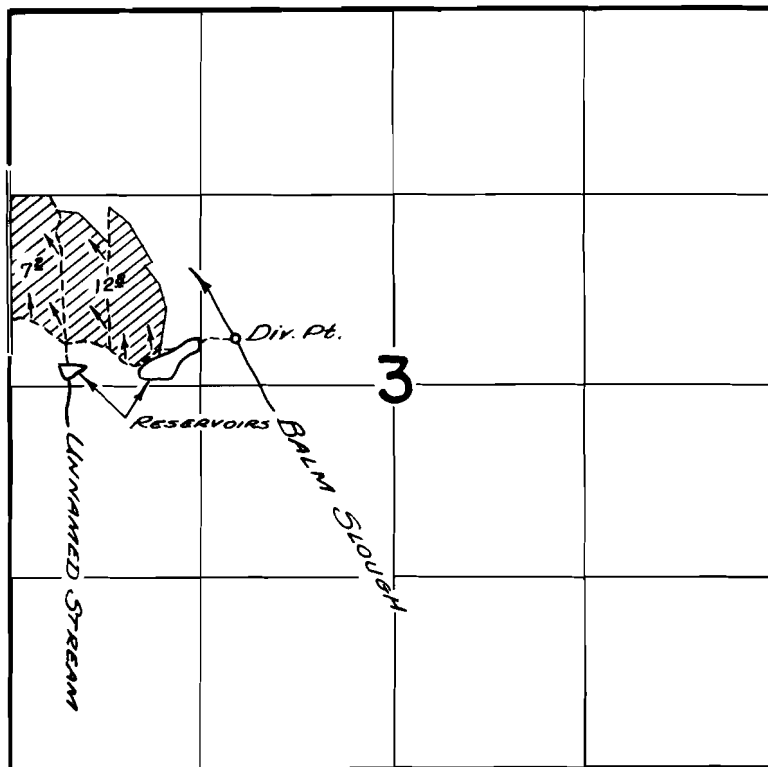

FINAL PROOF SURVEY
UNDER

Application No. ^{R-32321} 32250 Permit No. ^{R-2155} 25627
IN NAME OF

.....
Surveyed April 11 1961, by C. O. Bartlett