


T.41S.R.14E.W.M.

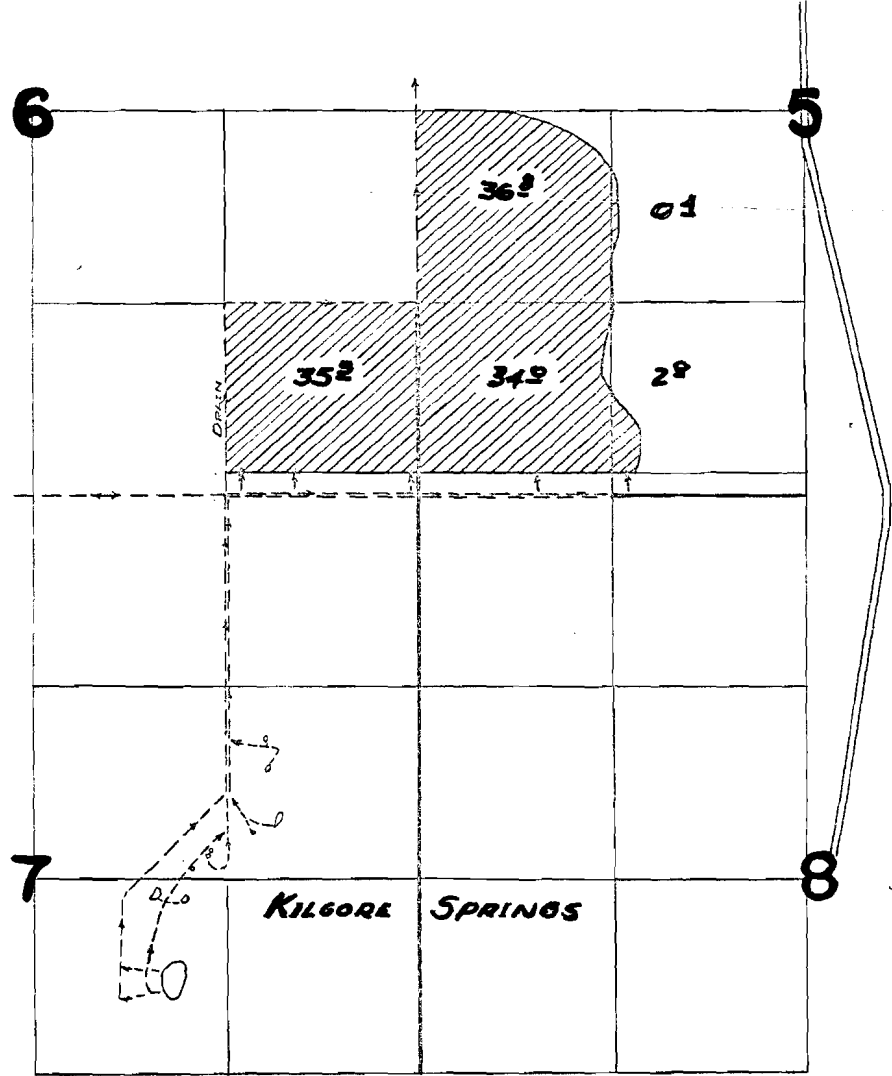

West River Mst.

FINAL PROOF SURVEY UNDER

Application No. 27711 Permit No. 21812
IN NAME OF

W. D. CAMPBELL

748 OCT. 60
Surveyed 12 APRIL 1961, by M. Bisha