


T. 39 S. R. 8 E. W. M.

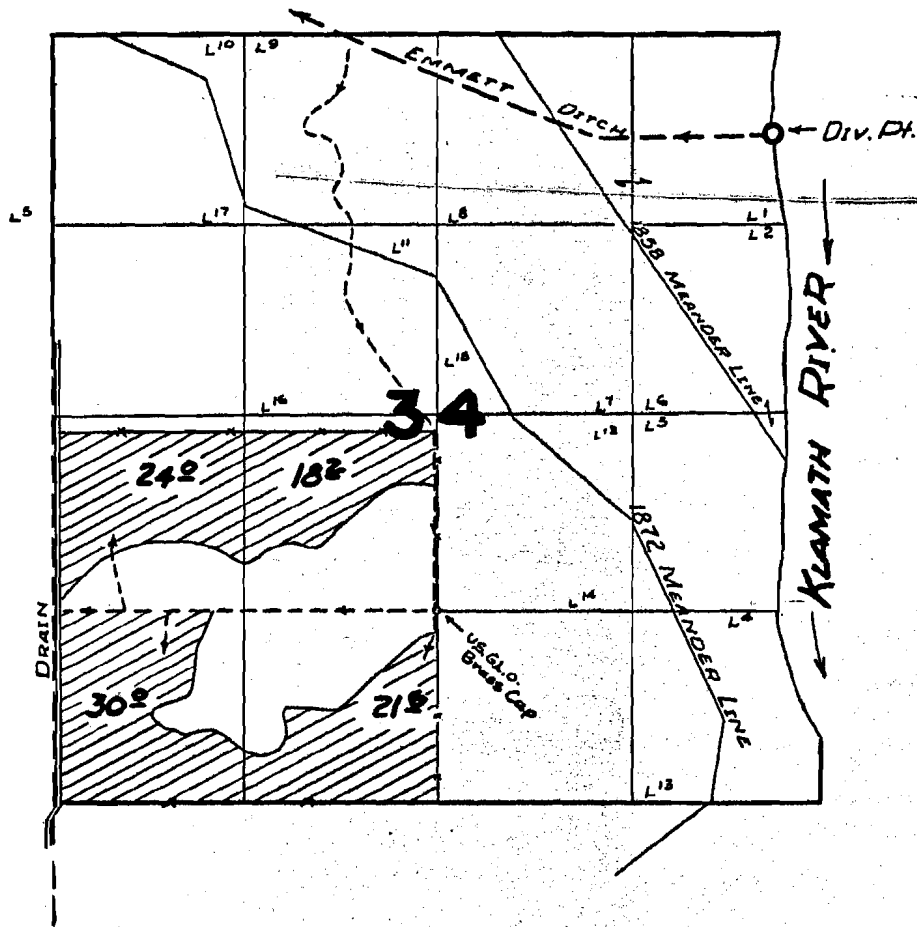

Klamath River

FINAL PROOF SURVEY UNDER

Application No. 29584 Permit No. 23298
IN NAME OF

Surveyed 14/17 APRIL 1961, by m. Bick