


T.16 S.R.4W.W.M.

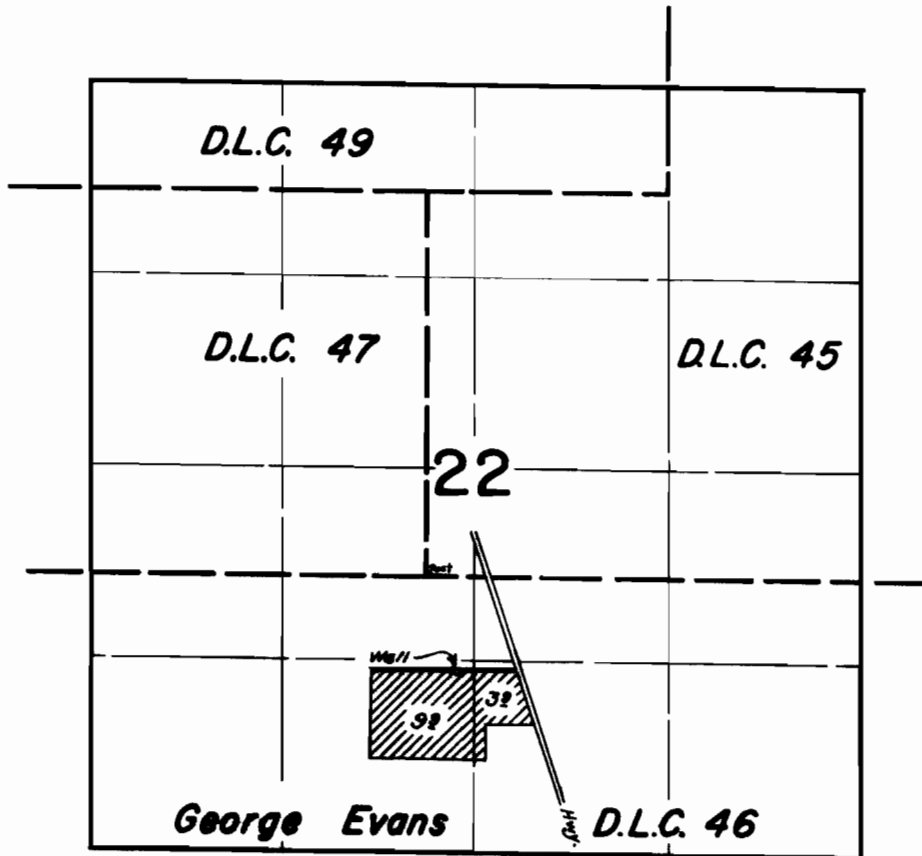

FINAL PROOF SURVEY  
UNDER

Application No. G-1108 Permit No. G-982  
IN NAME OF

BUD ANDREWS

Surveyed May 12, 1961, by R. Jackson