


T.21S.R.3W.W.M.

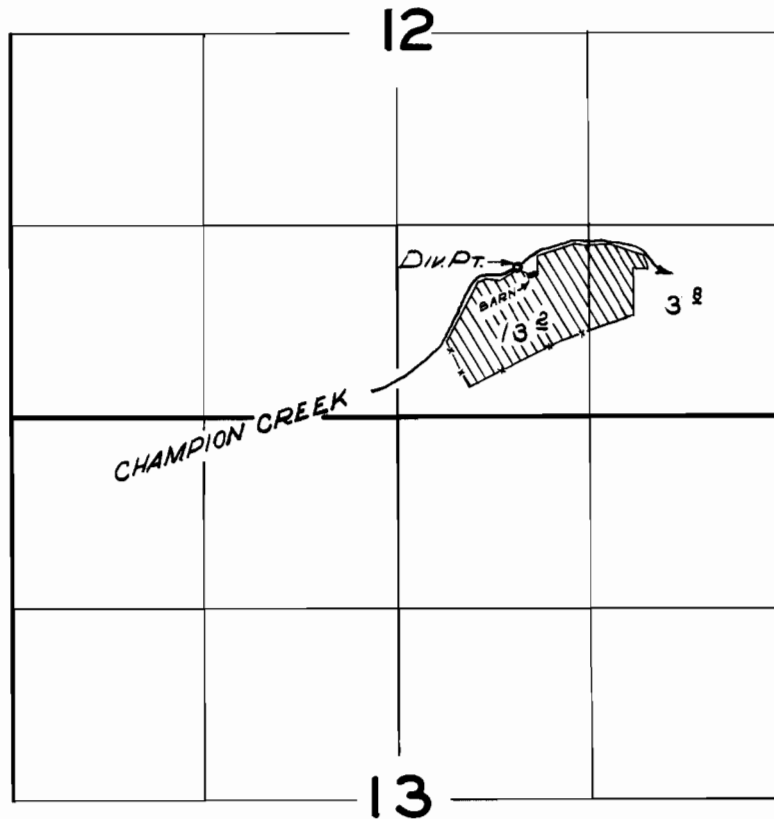

FINAL PROOF SURVEY
UNDER

Application No. 29978 Permit No. 23756
IN NAME OF

.....*WILLIAM PERINI*.....

Surveyed *May 22* 1961, by *M. BISH*.....