


T. 16 S. R. 6 W. W.M.

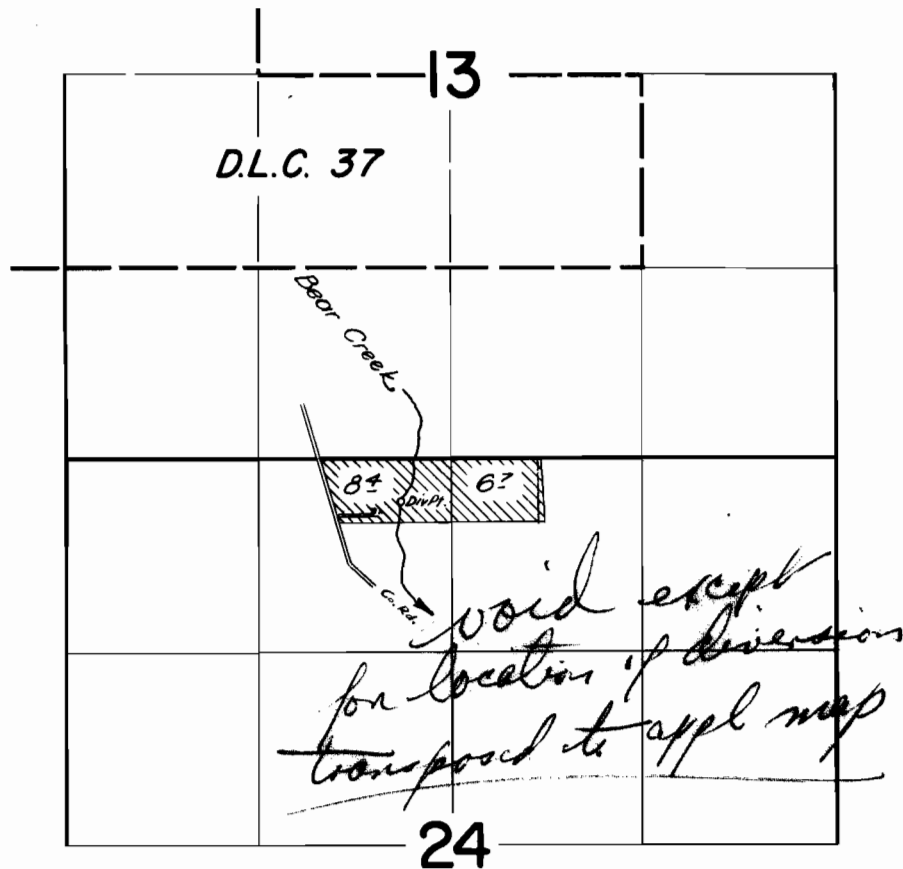

FINAL PROOF SURVEY
UNDER

Application No. 31480 Permit No. 24817
IN NAME OF

JOSEPH E. & MABEL M. OLAND

Surveyed May 9 1961, by *L. Jackson*