


T.17S.R.8W.W.M.

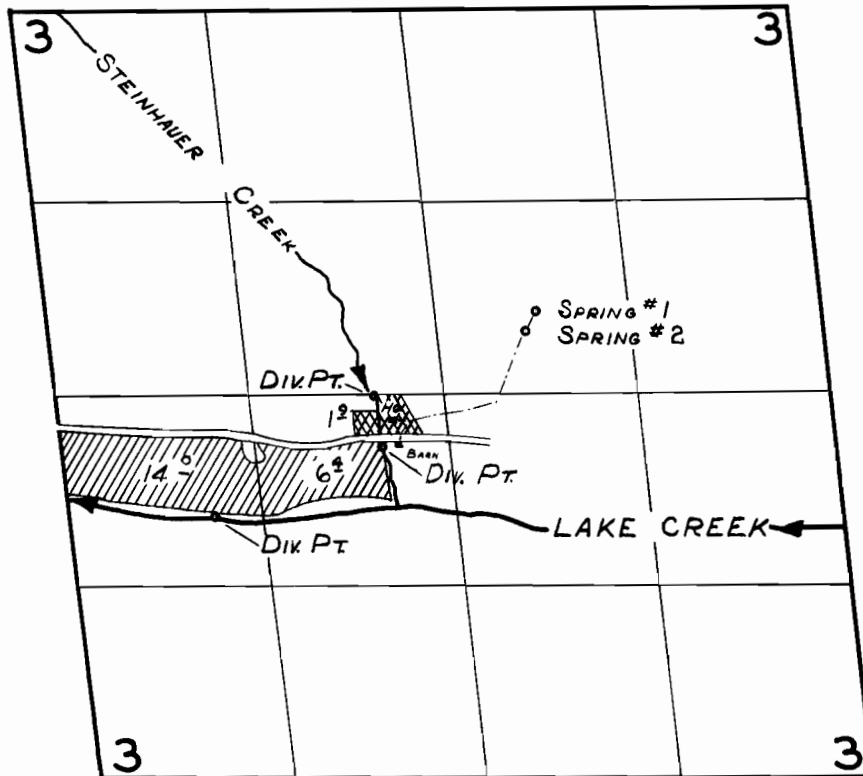

FINAL PROOF SURVEY
UNDER

LAKE CR.
STEINHAUER CR.



Application No. 31459 ... Permit No. 24843 ...
IN NAME OF

ED STEINHAUER

Surveyed MARCH 25 1959, by C.O. BARTELS