


T.20S.R.5W.W.M.

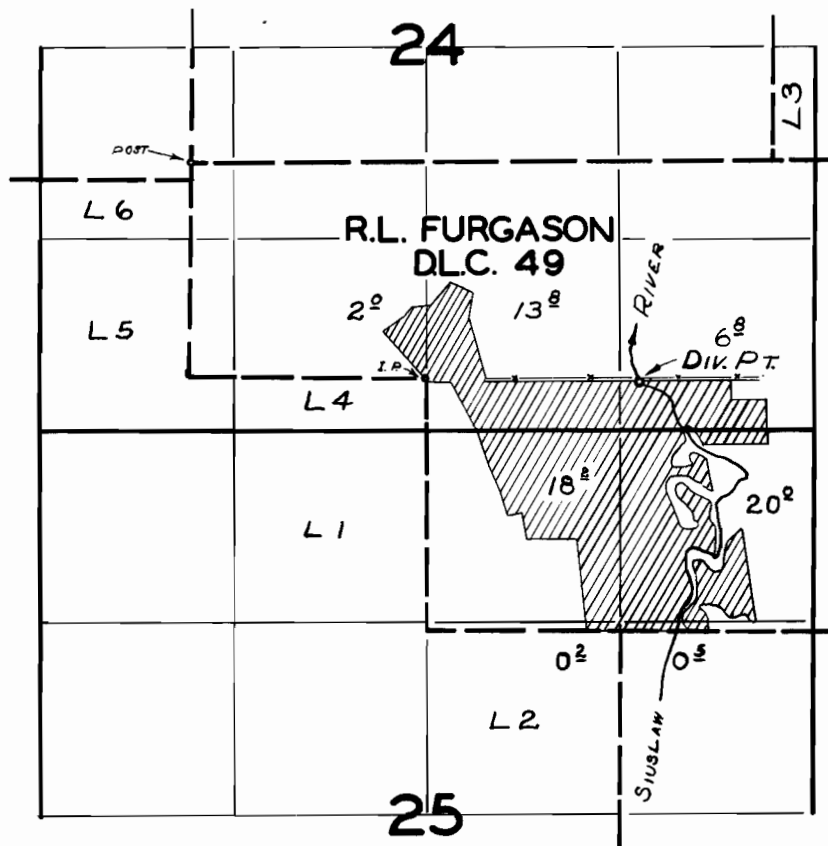

FINAL PROOF SURVEY
UNDER

Application No. 31807... Permit No. 25059...
IN NAME OF

ARTHUR M. NELSON

Surveyed *May 25* 1961, by *M. BISH*