


T.21S.R.3E.W.M.

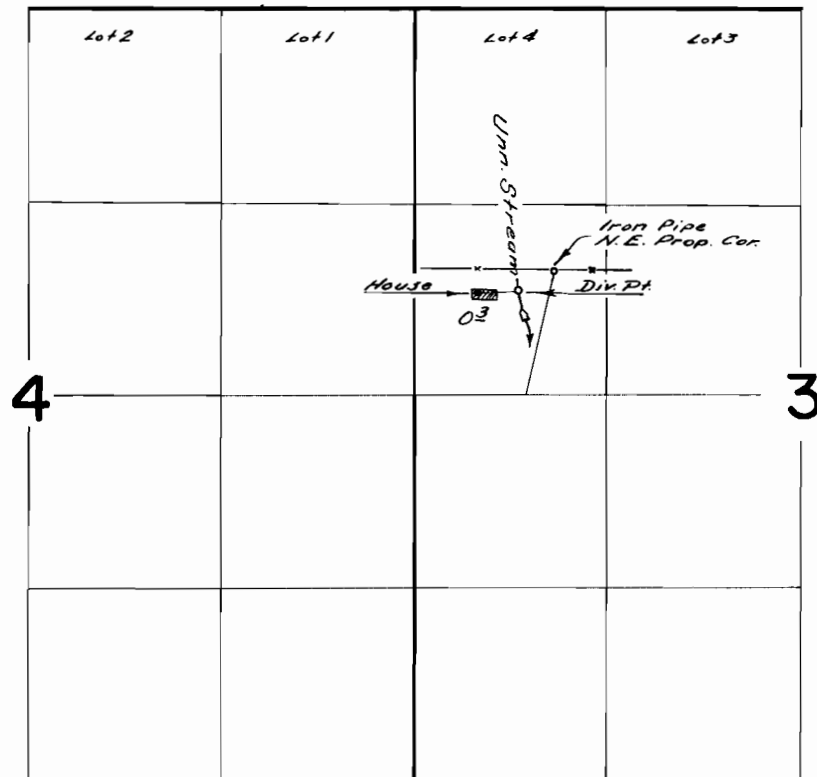

FINAL PROOF SURVEY
UNDER

Application No. 31567 Permit No. 25359
IN NAME OF

Surveyed Nov. 14 1961, by F. Siegmund