


T.16S.R.12W.W.M.

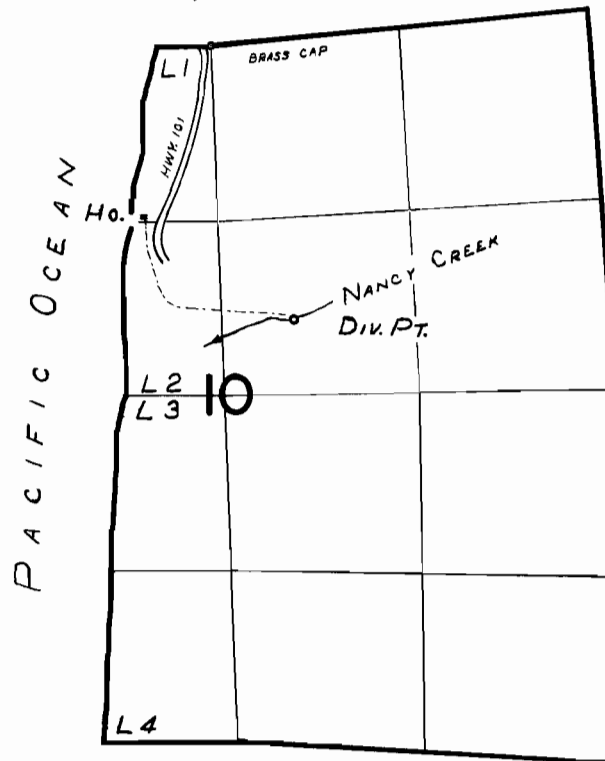

FINAL PROOF SURVEY
UNDER

Application No. 32287... Permit No. 25460...
IN NAME OF

EDWIN M. WHEELER

Surveyed JUNE 6, 1961, by C.O. BARTELS