


T.20S.R.3W.W.M.

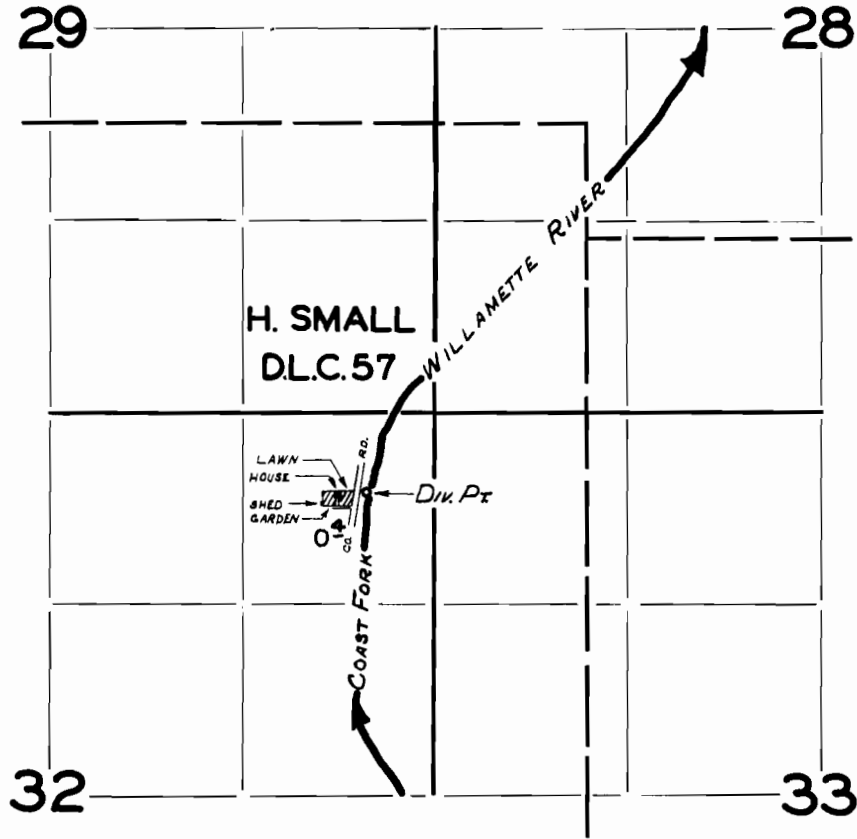

**FINAL PROOF SURVEY**  
UNDER

Application No. 32564... Permit No. 25707...  
IN NAME OF

*DEAN L. & HARRIET WEBB*

Surveyed *MAY 24*, 1961, by *M. BISH*