


T.16S.R.7 W.W.M.

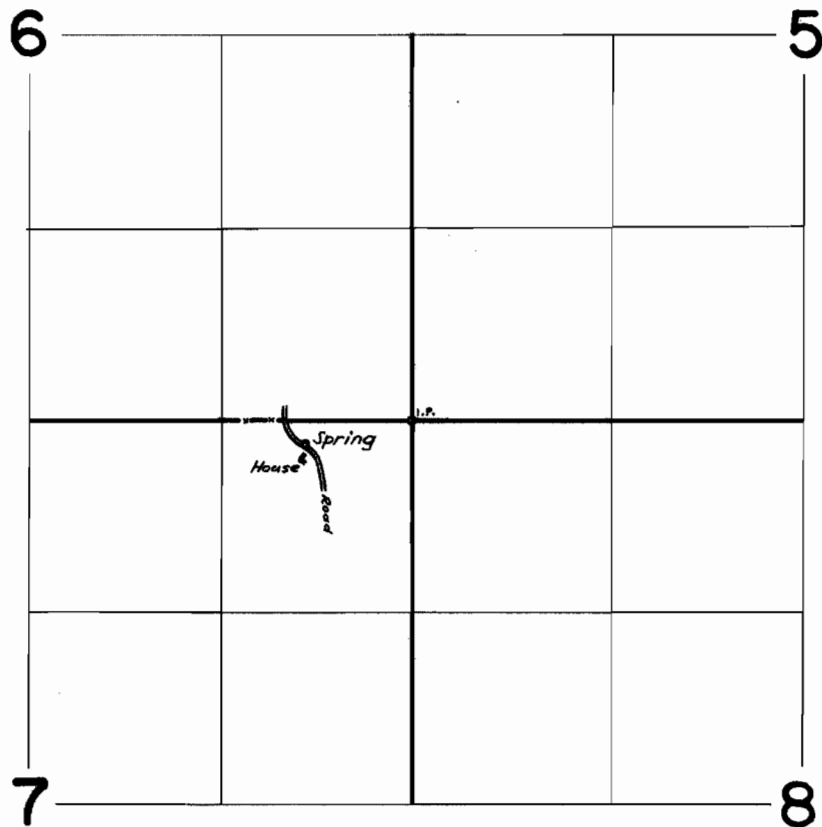

FINAL PROOF SURVEY
UNDER

Application No. **33690** Permit No. **26631**
IN NAME OF

ROLLIE R. SYPHERS

Surveyed *May 24* 1961, by *R. Jackson*