


T.22S.R.IW.W.M.

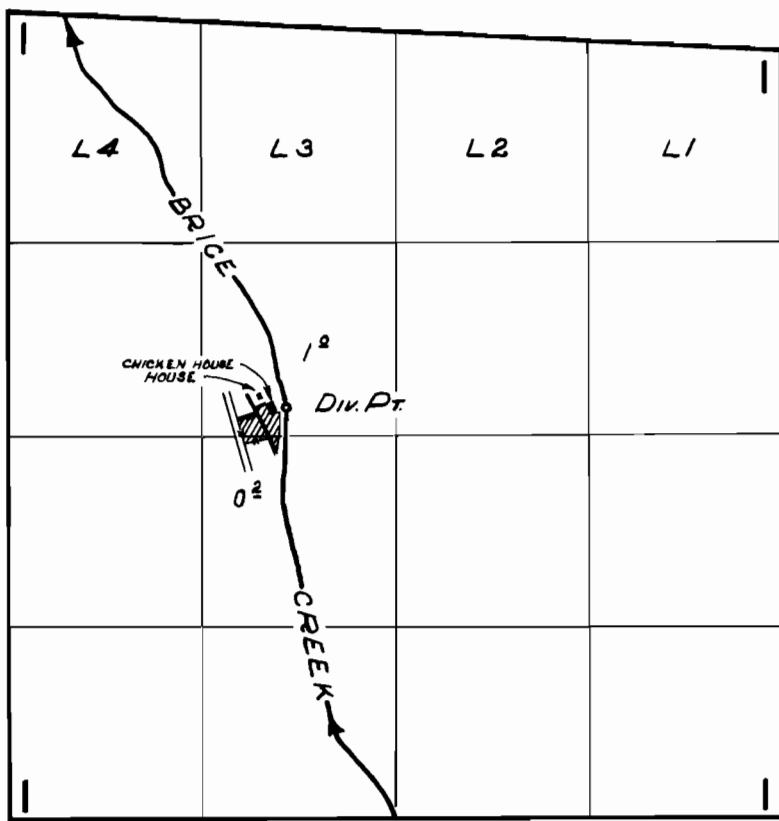

FINAL PROOF SURVEY UNDER

Application No. 34036... Permit No. 26840..
IN NAME OF

.....*LEE JONES*.....

Surveyed *MAY 23 1961.*, by *M. BISH*.....