


T.14S.R.3W.W.M.

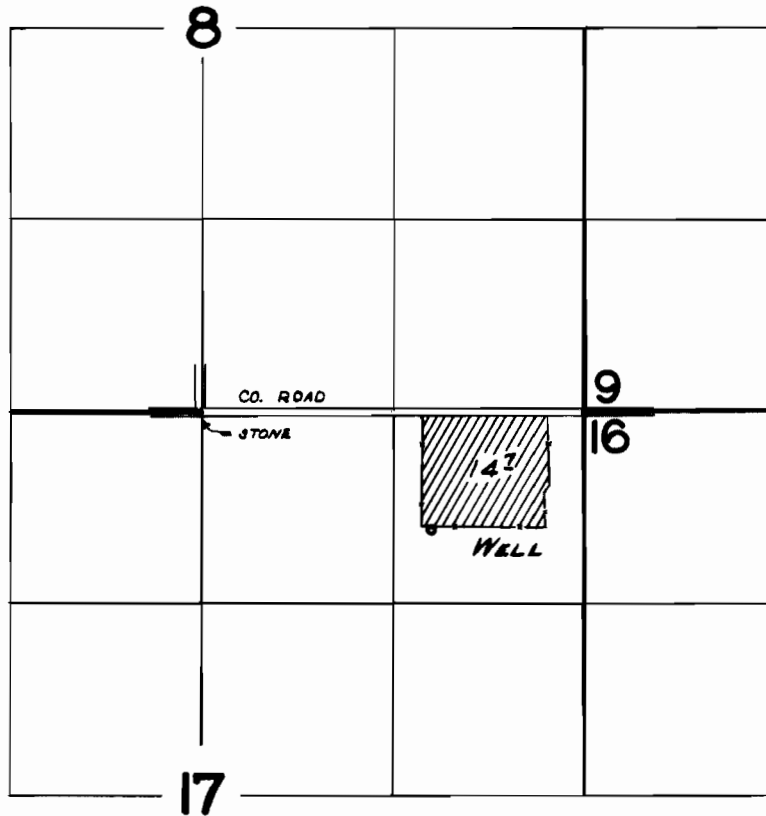

**FINAL PROOF SURVEY**  
UNDER

Application No. ~~G-869~~. Permit No. ~~G-769~~.  
IN NAME OF

**MERWIN L. & GRACE J. VANNICE**

Surveyed *JUNE 19, 1961*, by *M. BISH*.....