


T.10S.R.3W.W.M.

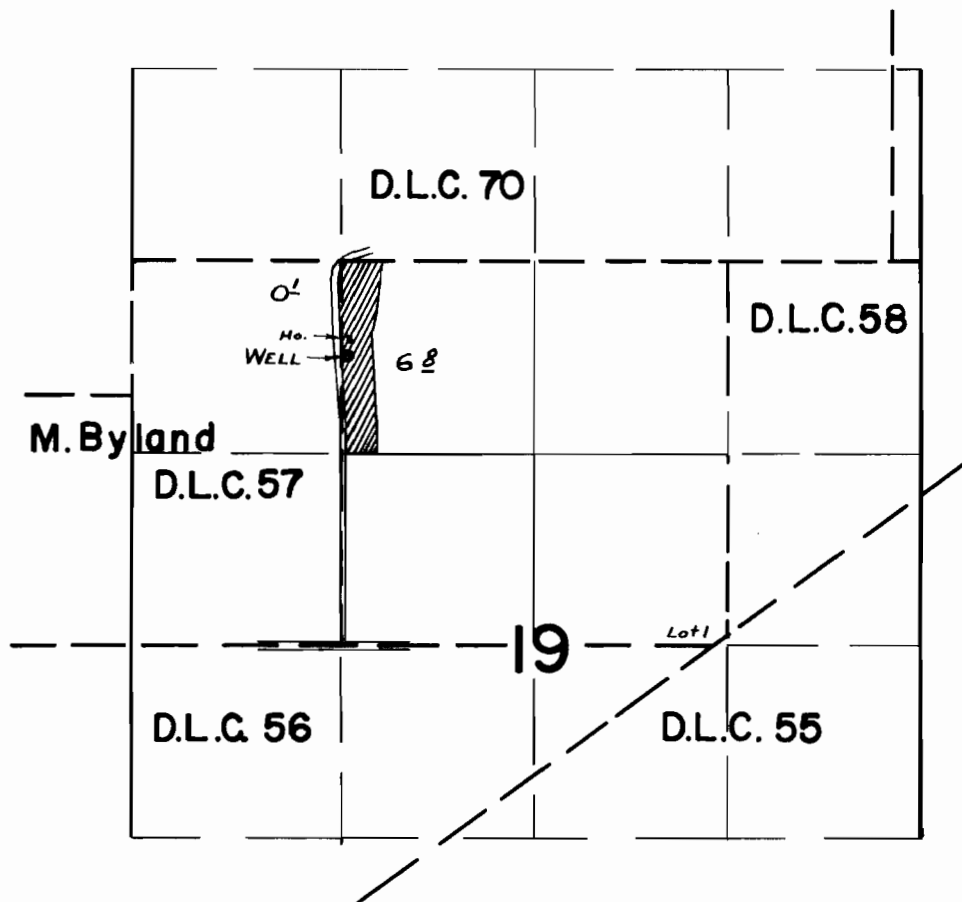

FINAL PROOF SURVEY UNDER

Application No. G-1024 Permit No. G-883
IN NAME OF

WILLIAM E. & DONNA J. BRENNAN

Surveyed 19 MAY 1961, by M. Bish