


T.13S.R.1W.W.M.

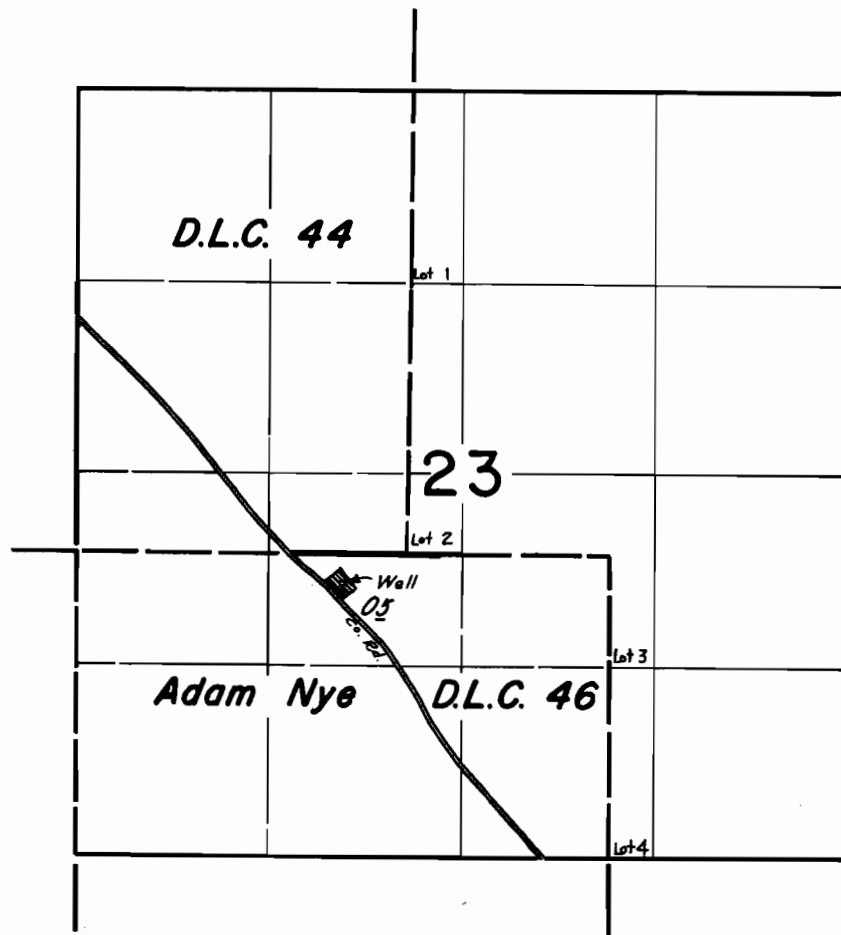

FINAL PROOF SURVEY
UNDER

Application No. G-1293 Permit No. G-1137
IN NAME OF

GLENN W. & ALICE E. HILL

Surveyed August 27 1959, by R. Jackson