


T.I.S.R. I.W.W.M.

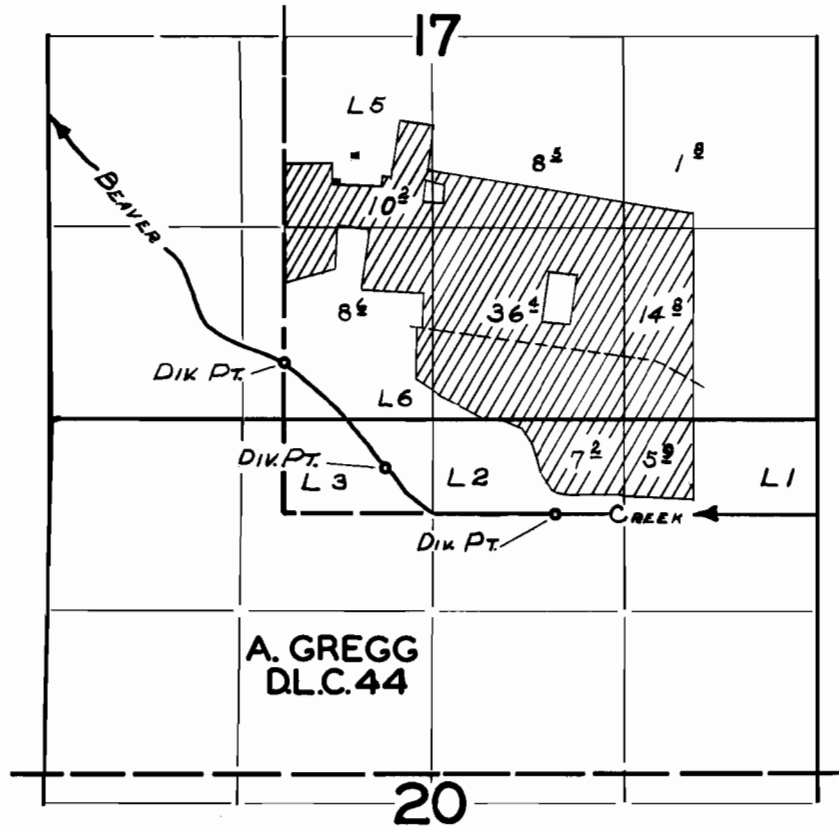

FINAL PROOF SURVEY
UNDER

Application No. **30153**... Permit No. **23791**...
IN NAME OF

.....**GILBERT & ROMNA CHARTRAW**.....

Surveyed *Sept. 6, 1961*, by *M. B. Ish*.....