


T.16S.R.4W.W.M.

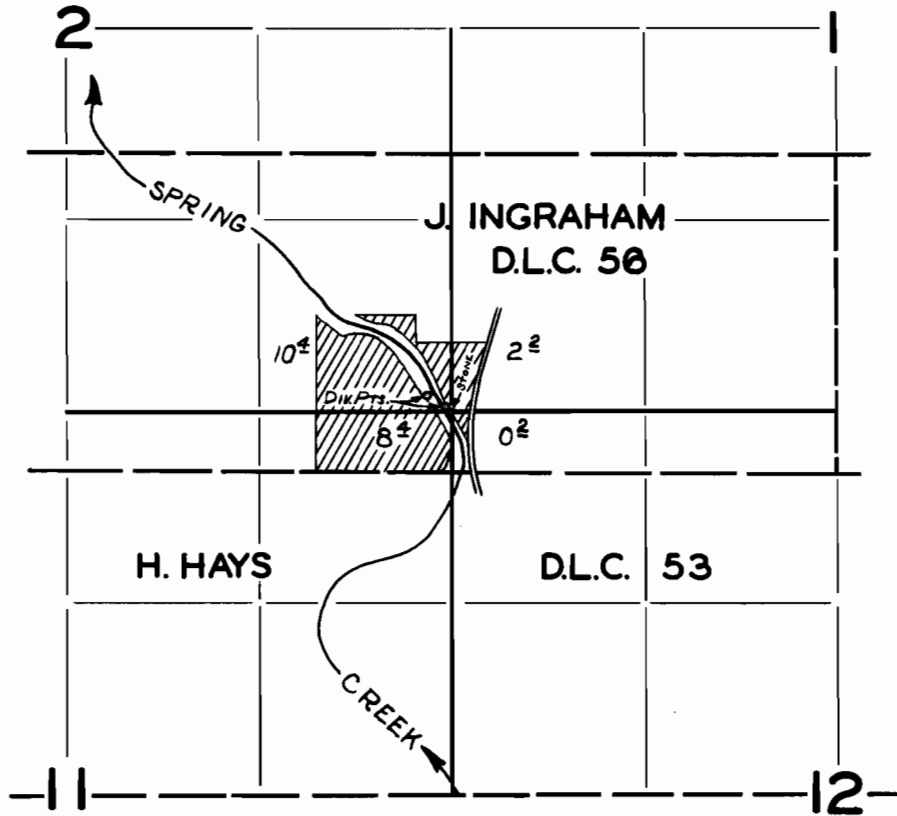

FINAL PROOF SURVEY
UNDER

Application No. 31363... Permit No. 24732...
IN NAME OF

.....**EDITH HURD**.....

Surveyed *JUNE 21 1961*, by *M. BISH*.....