


T.9S.R.2E.W.M.

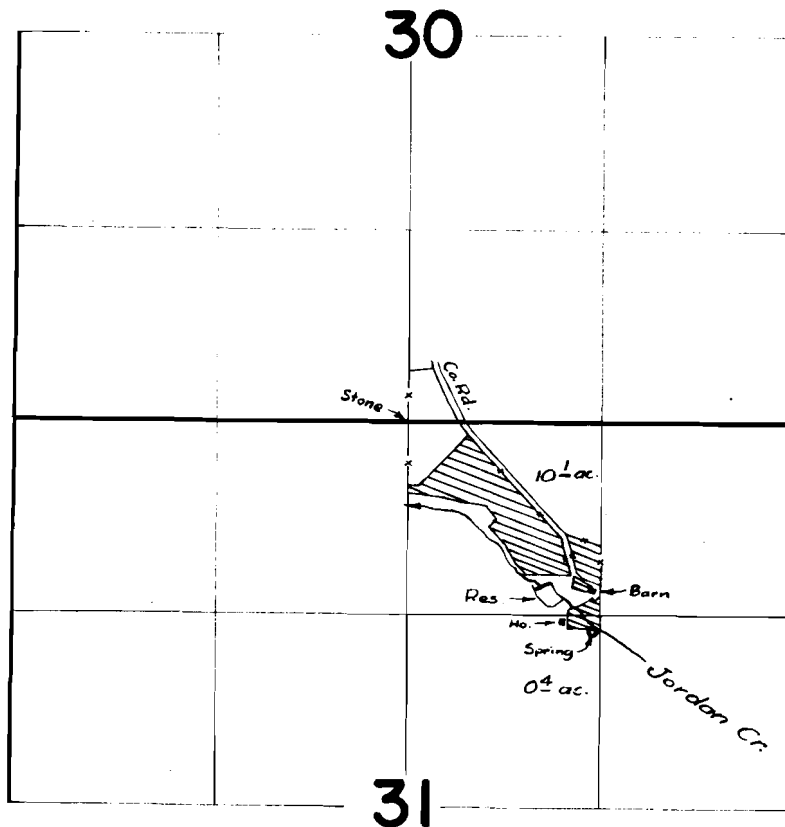

FINAL PROOF SURVEY
UNDER

Application No. ³¹⁹⁴⁸ ~~P-31947~~ Permit No. ²⁵¹⁸⁶ ~~P-2088~~
IN NAME OF

JAMES & EFFIE TOOMB

Surveyed 17 MAY 1961 by *Mr. Bish*