T.11S.R.2W.W.M.

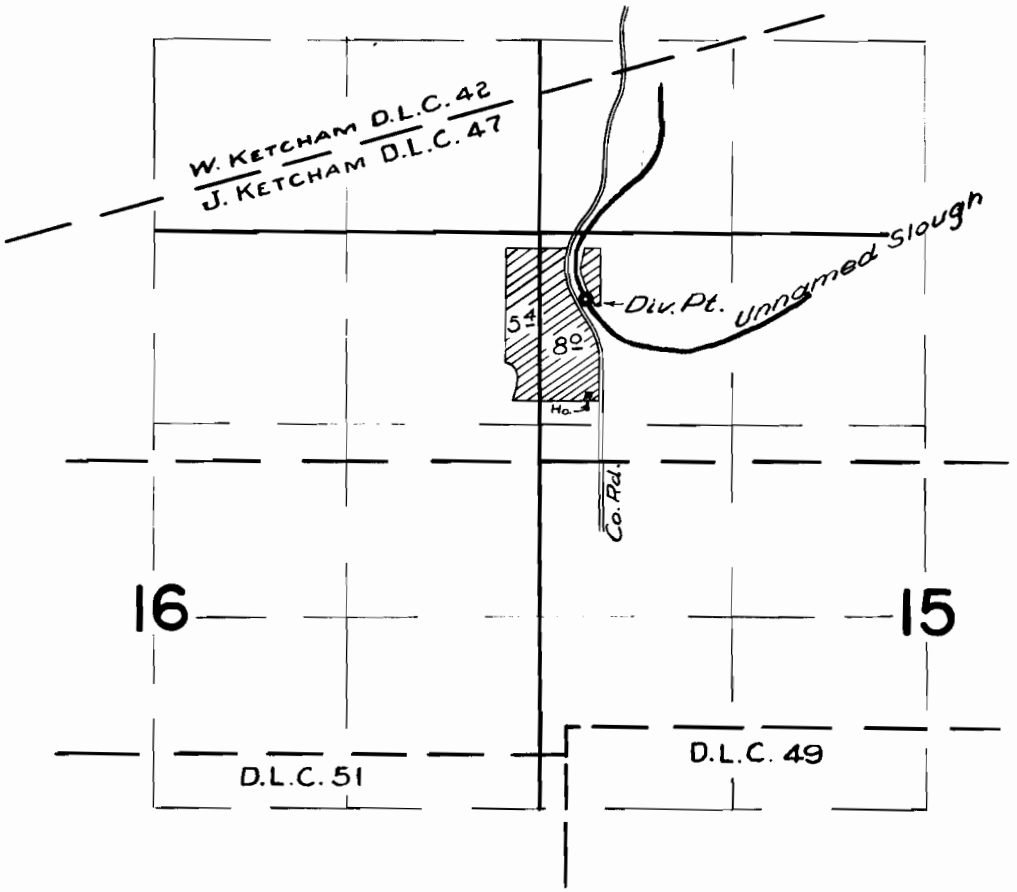

FINAL PROOF SURVEY
UNDER

Application No. 32672 Permit No. 25798
IN NAME OF

ROBERT LYLE & MARY LORENE VOGT

Surveyed 1 JUNE 1961, by M. Bish

DFM-2P-67