


T.12S.R. I.W.W.M.

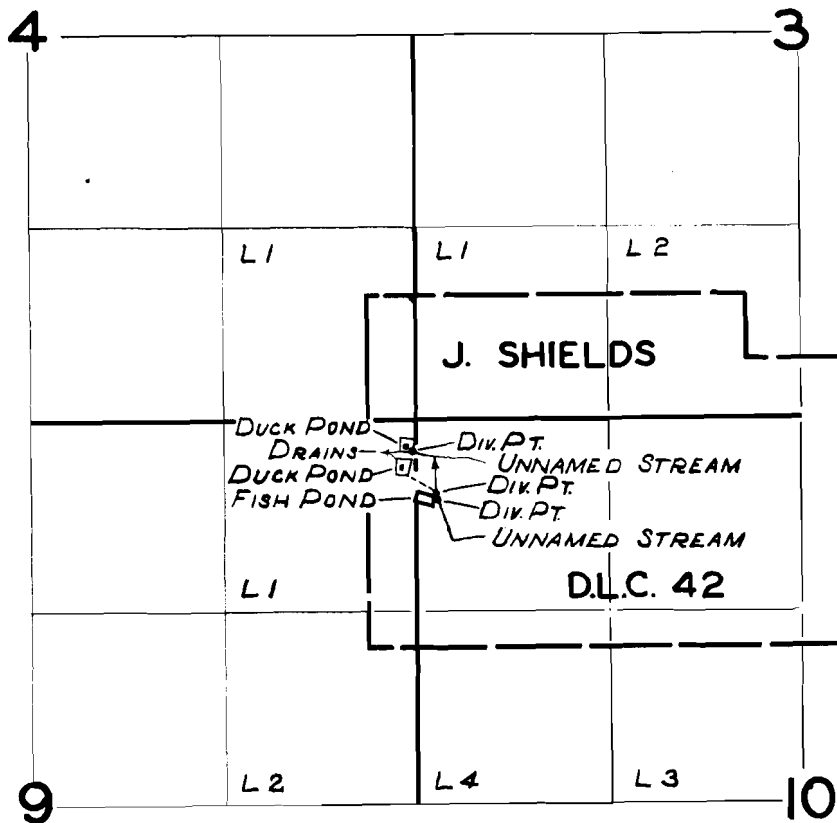

FINAL PROOF SURVEY
UNDER

Application No. *R-33092* *R-2242*
33093 Permit No. 26164
IN NAME OF

HUGH & MINNIE CLARK

Surveyed *JUNE 5* 1961, by *M. BISH*