


T.10S.R.2W.W.M.

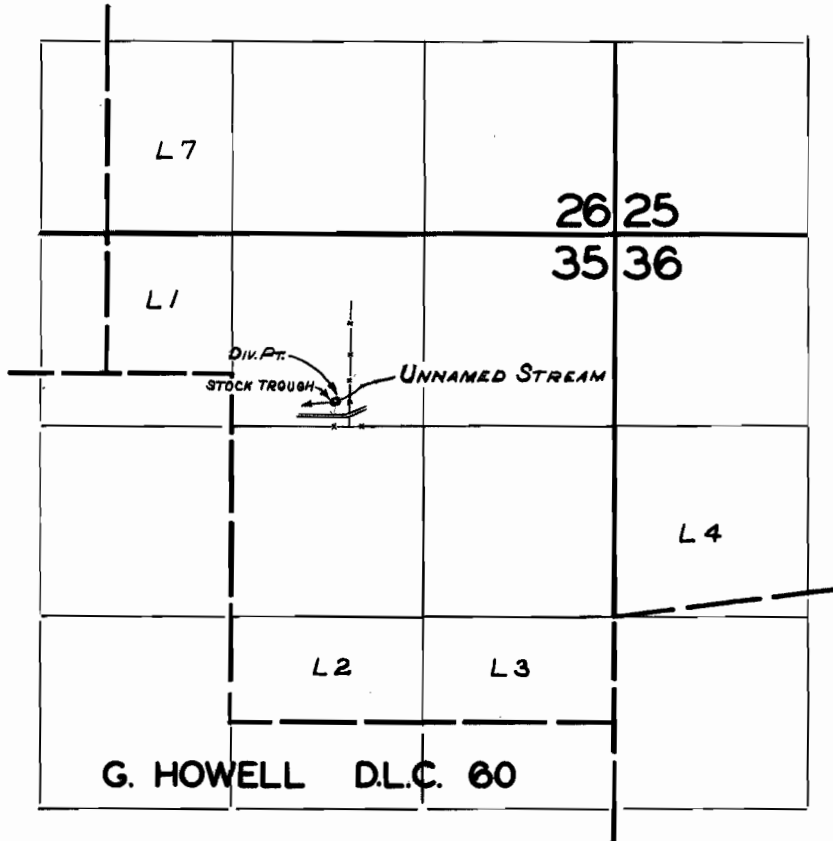

FINAL PROOF SURVEY
UNDER

Application No. 33364... Permit No. 26607...
IN NAME OF

EDWIN & VIRGINIA KEECH

Surveyed Sept. 6, 1961, by M. Bish