


# T.11S.R.2W.W.M.

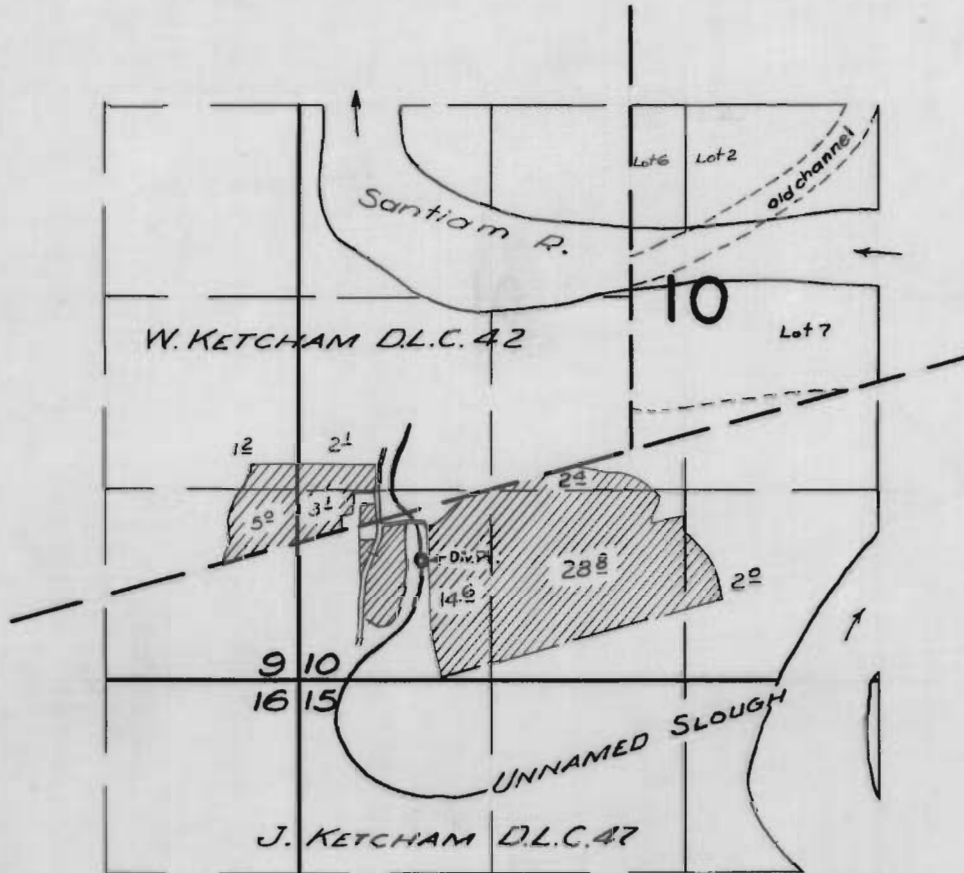

## FINAL PROOF SURVEY UNDER

Application No. 26954 Permit No. 34223  
IN NAME OF

MRS. JOHN BLAKELEY

Surveyed 1 JUNE 1961, by Tracy Bishop