


# T.17S.R.47E.W.M.

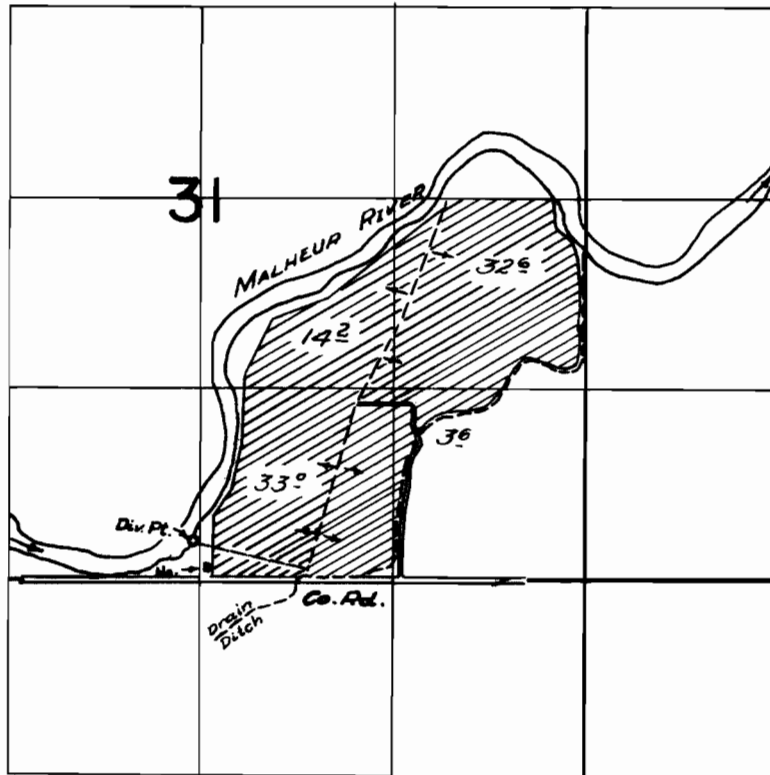

## FINAL PROOF SURVEY UNDER

Application No. 30613 Permit No. 24112  
IN NAME OF

CLARENCE RULE

Surveyed 27 Oct. 1960, by Tom R. Jackson  
19 Oct. 1961