


T.6S.R.2W.W.M

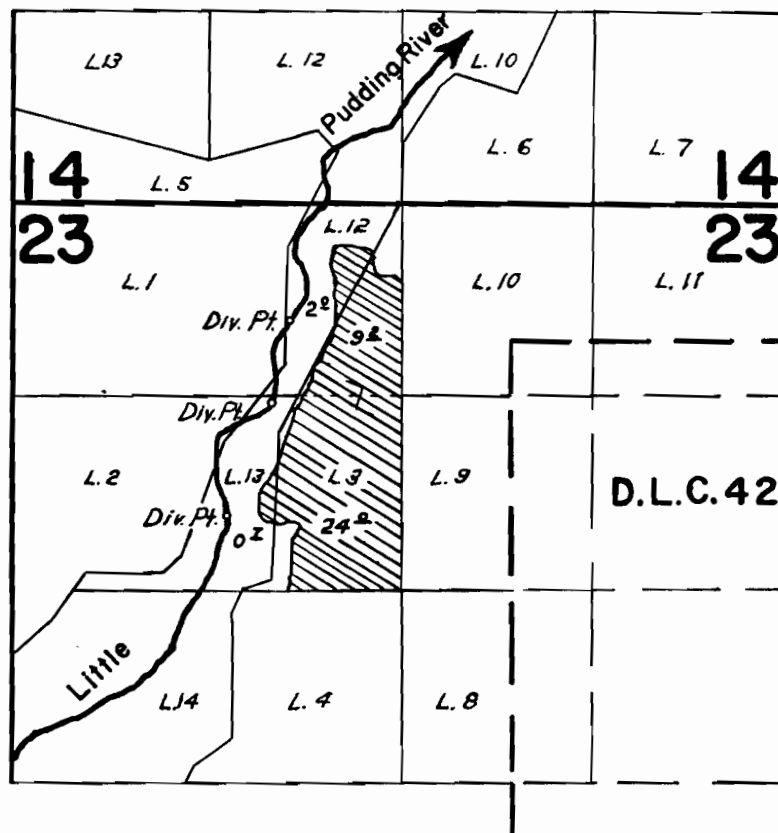

FINAL PROOF SURVEY UNDER

Application No. 28382 Permit No. 22392
IN NAME OF

Estate of John E. Wood

Surveyed July 18, '56 by M. Bish
 May 31, 1960, by C. O. Bartels
 Sept. 29, '61 C. O. Bartels