


T. 9 S. R. 2 E. W. M.

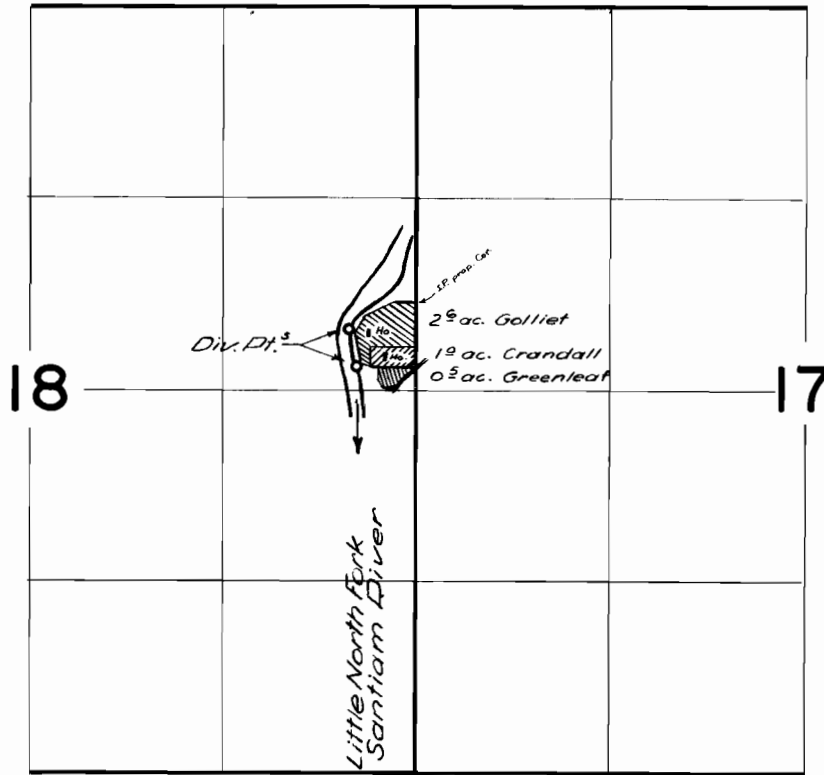

FINAL PROOF SURVEY
UNDER

Application No. 32165 Permit No. 25376
IN NAME OF

KEN GOLLIET

Surveyed 5 JULY 1961, by M. Bish