


T.3S. R.24E.W.M.

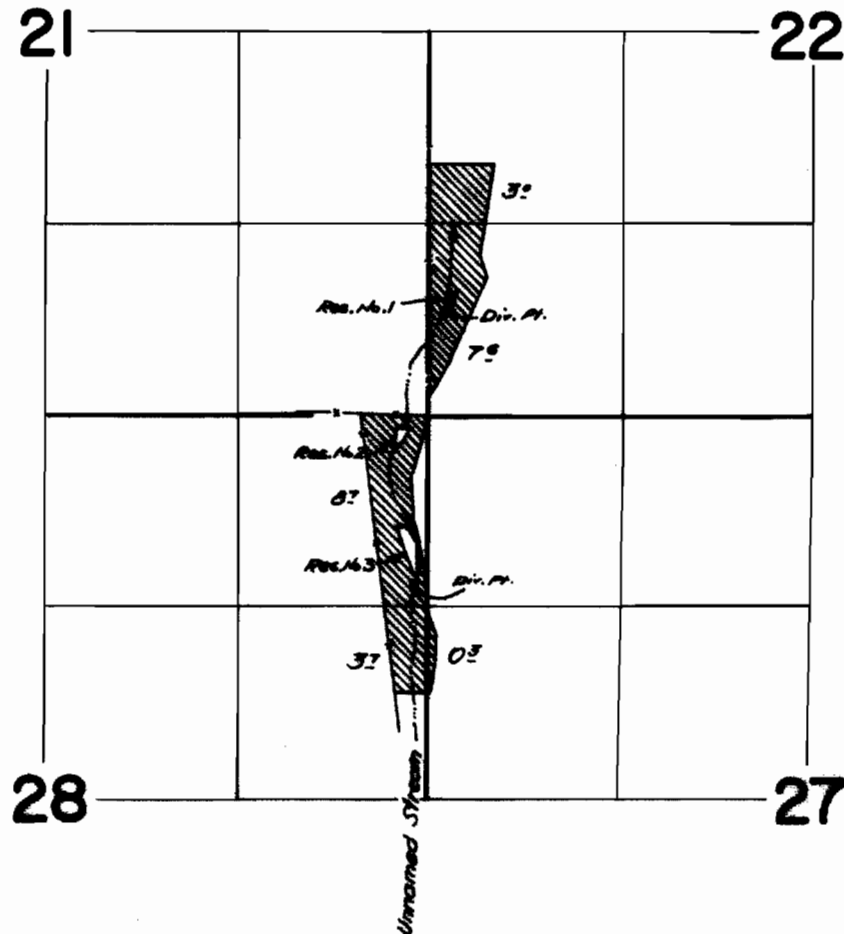

FINAL PROOF SURVEY
UNDER

Application No. R-28854 Permit No. R-1548
27750 28482
IN NAME OF

OREN O. BRACE

Surveyed October 12, 1901, by A. Jackson