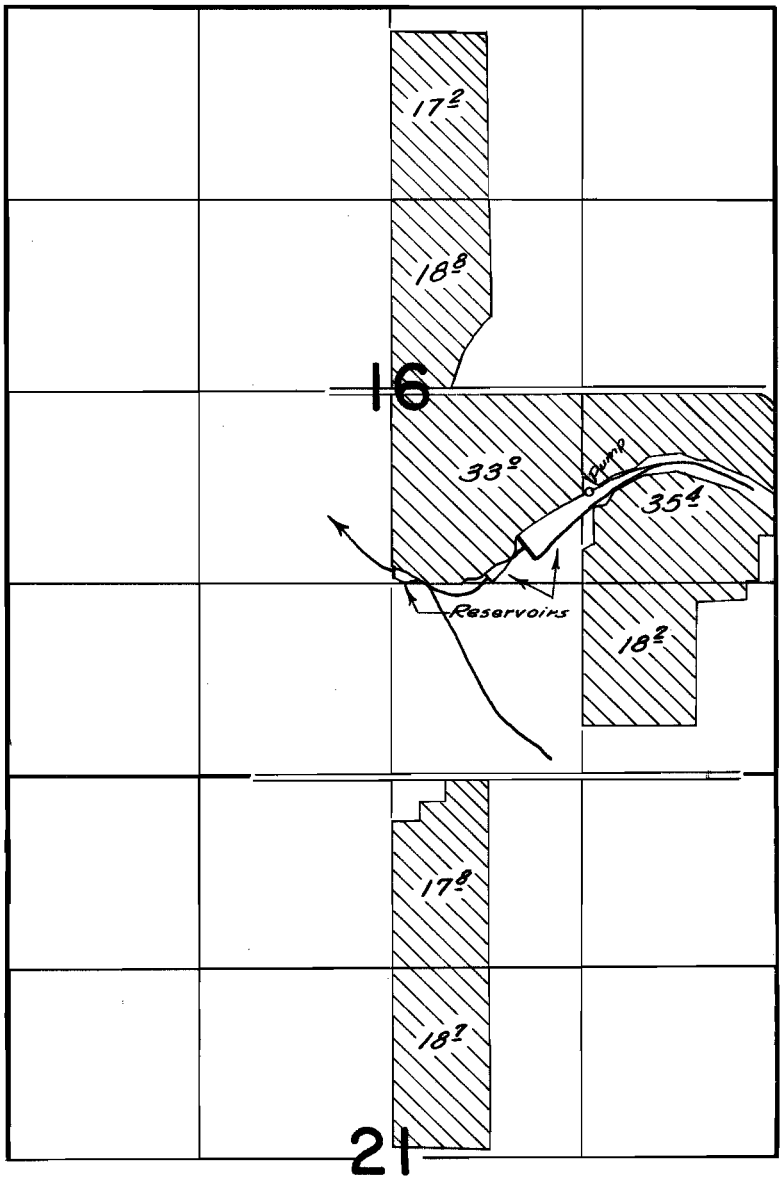

T.1S. R.4E.W.M.

FINAL PROOF SURVEY

Application No. R-32586 32874 R-32315 32316 Permit No. R-2213 25964 R-2143 25526

IN NAME OF

WILLIAM H. SESTER

Surveyed Aug. 16 1961, by C. Bartels

DFO-4D-09 & 1961-U