


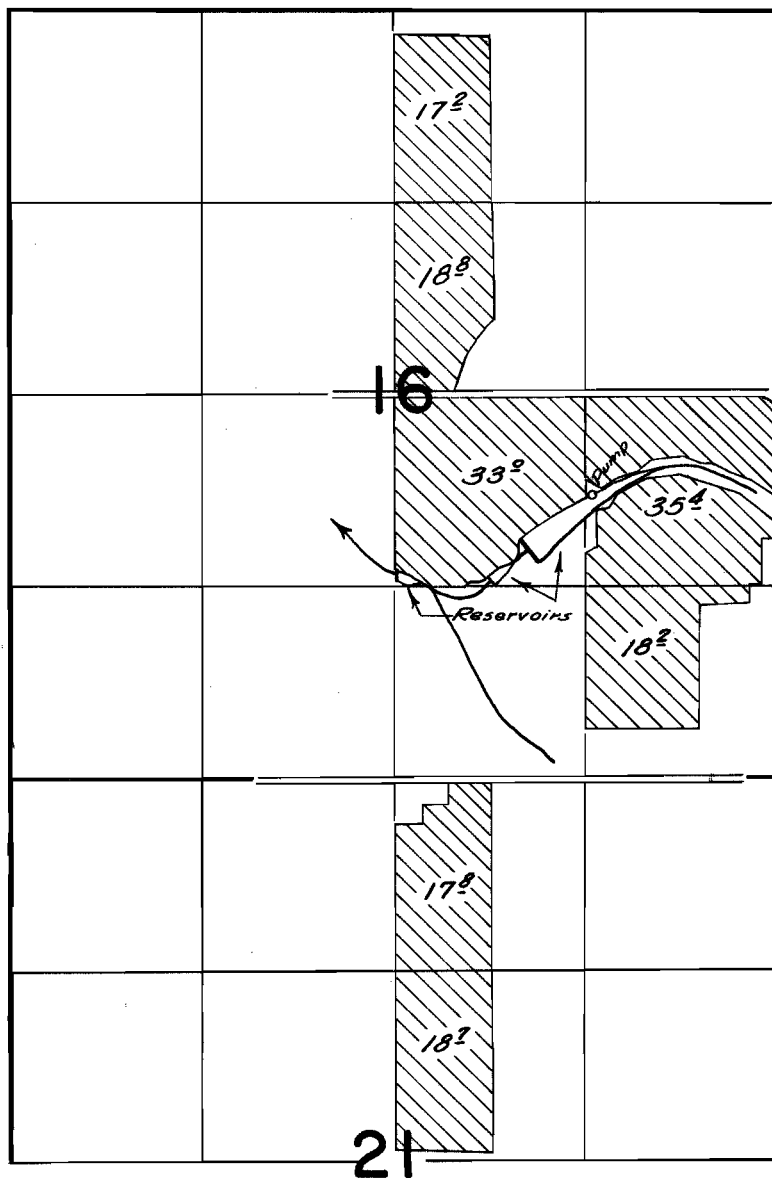

T.1S.R.4E.W.M.

FINAL PROOF SURVEY

Application No. R-32586 Permit No. R-2213
32874 25964
R-32315 R-2143

IN NAME OF

WILLIAM H. SESTER

Surveyed Aug. 16, 1961, by C. Bartlett